Ness


KANSAS

SECTION 21 TOWNSHIP 18S RANGE 22W

WELL NO. #1-21 Grose

COMPANY P.E.P.L.

3

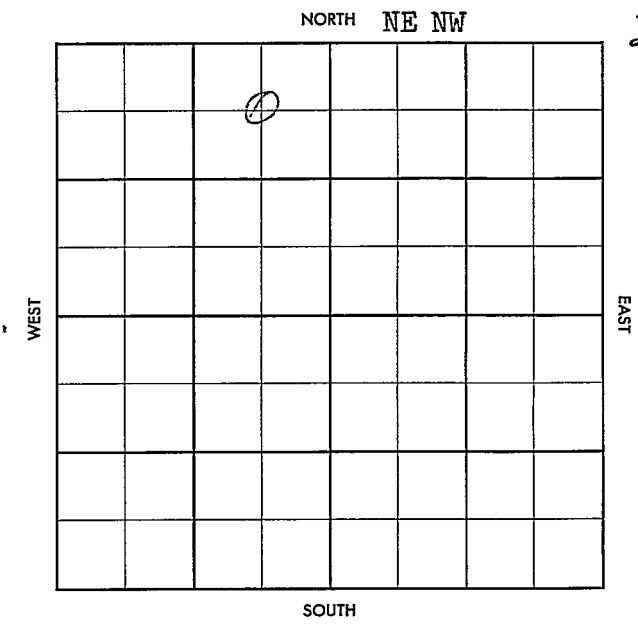

FORM 513 SUNRAY

County Ness Elev.

Sec. 21 Twp. 18S Rge. 22W

Company P.E.P.L.

Farm Name Grose No. 1-21

TOPS	DEPTH	LOG	DATUM
Anh.			
Tp.			
H.			
Tr.			
Dg.			
B.L.			
L.			
K.C.			
B.K.C.			
Ce.			
C.			
M.			
M.			
K.			
Mz.			
Mo.			
V.			
S.			
S.			
A			
R.			
P€.			
G.			
T.D.			

Loc. in Sec. NE NW

Geol.

Contr.

Pool

AUG 7 '57

FIRST REPORT

Date Comm. 7-26-57

6-5/8" at 760

Co. Lse. No. Sec. T. R.

FORM 513 SUNRAY

County Ness Elev. 2248 DF

Sec. 21 Twp. 18S Rge. 22W

Company P.E.P.L.

Farm Name Grose No. 1-21

TOPS	DEPTH	LOG	DATUM
Anh.	1525		
Tp.			
H.	3692	3687	
Tr.	3710	3708	
Dg.			
Bl.			
L.	3738	3735	
K.C.			
B.K.C.		4098	
Ce.			
C.		4112	
M.	4318	4098 → 4201	
M.			
K.			
Mz. Che		4237	
Mo.			
V.		4490	
S.			
S.			
A		4673	
R.			
P€.			
G.			
T.D.	4850		

Loc. in Sec. NE NW

Geol.

Contr.

Pool

AUG 21 '57

ABANDONED

Date Comm. 7-26-57 Log.

8-5/8" at 760 [illegible] X D 4700 [illegible]

No test D&A

Co. Lse. No. Sec. T. R.