

Form 51—5M—9-28—27423

Map No. **KANSAS** Sec. 22 Twp. 27 R. 3

Well No. X #7-Wellits Farm Empire O & R. Company

NORTH

[illegible]

SOUTH

Location_____

Drilling Remarks

Rig Up.....

Drilling Remarks

RECORD

Cased.....in.....ft.

Sand.....

Gas.....

Oil_____

Total Depth.....

PRODUCTION

1st 24 hrs. Nat.....

1st 24 hrs. after shot.....


Gas.....cu. ft.....

Dry Hole.....

Abandoned.....

Map No. **KANSAS** Sec. 22 Twp. 27 R. 5
 Well No. #7-Willits Farm
Empire O & R. Company

.....Ft. from N. Line
330 Ft. from S. Line
330 Ft. from E. Line
Ft. from W. Line

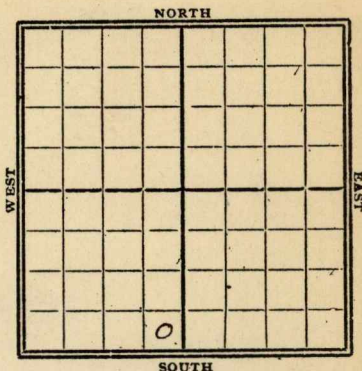

1928

Date

REPORT

11/21	Location
11/28	Rigging up
12/5	
12/12	Spdg 200'
12/19	drlg. 775'
12/26	" 1230'
1929	
1/2	" 2200'
1/9	" 2375'
1/16	sand 2731-60'
	T.D. 2760'
	shot 60 gts
	200 bbls oil
	Pump

Butler

K11 KANSAS

MAP No. _____ SEC. 22 TWP. 27 R. 5

WELL No. 6

Willits
Empire Oil Co

COMPANY

CONTRACTOR

FIRST REPORTS

SECTION PLAT

	0		

Ft. FROM N. LINE

330

Ft. FROM S. LINE

330

Ft. FROM E. LINE

Ft. FROM W. LINE

LOCATION ✓

RIG UP

DRILLING AND REMARKS:

RECORD

CASED _____ IN. _____ FT.

SAND _____

GAS _____

OIL _____

TOTAL DEPTH _____

PRODUCTION

1ST 24 HRS. NAT. _____

1ST 24 HRS. AFTER SHOT _____

GAS _____ Cu. Ft.

DRY HOLE _____

ABANDONED _____

DATE

NOV 21 1922

CHAS. L. SHERWOOD

192

SCOUT

K11
Map No.

KANSAS

Sec.

Twp.

R.

Well No.

Empire Oil & Gas Co. Company

Contractor

CORRECTION

Ft. from N. Line

330

Ft. from S. Line

330

Ft. from E. Line

Ft. from W. Line

SECTION PLAT

Location

RECORD

Cased in., ft.

Rig up

Sand

Drilling and Remarks:

Gas

Oil

Total Depth

PRODUCTION

1st 24 hrs. Nat.

1st 24 hrs. after shot

Gas Cu. Ft.

Dry Hole

Abandoned

Date

DEC 12 1928

CHAS. L. SHERWOOD

192

Scout

Butler

MAP No. 11 **KANSAS** SEC. 22 TWP. 27 R. 5

WELL No. 7 Willets
Empire O & R Co COMPANY

CONTRACTOR

COMPLETE**SECTION PLAT**

Ft. FROM N. LINE

330

Ft. FROM S. LINE

330

Ft. FROM E. LINE

Ft. FROM W. LINE

LOCATION _____

RIG UP _____

DRILLING AND REMARKS:

60/200 Bls**RECORD**CASED 2731 IN. 2760 FT.SAND 2731-2760

GAS _____

OIL _____

TOTAL DEPTH 2760**PRODUCTION**

1ST 24 HRS. NAT. _____

1ST 24 HRS. AFTER SHOT _____

GAS _____ CU. FT.

DRY HOLE _____

ABANDONED _____

DATE

JAN 16 1929**CHAS. L. SHERWOOD**192

SCOUT