Marion

KANSAS


SECTION 9 TOWNSHIP 19S RANGE 4E

WELL NO. #1 McCarty

COMPANY J.T. Hannah

NORTH

NW ~~NE~~ SE SW

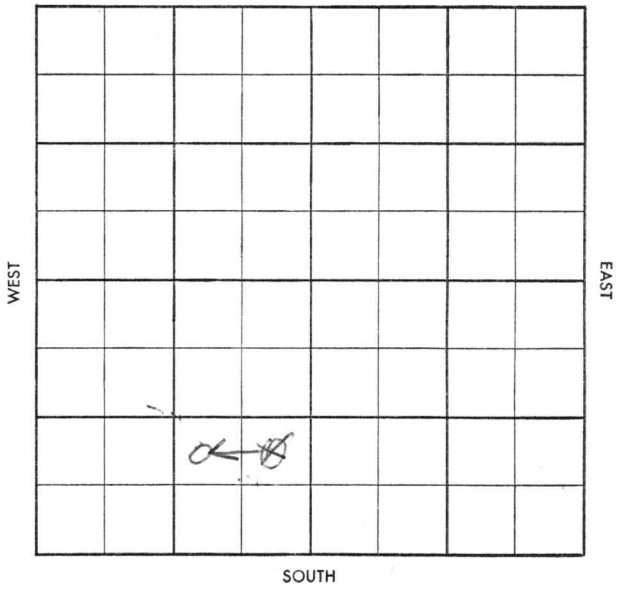

Twp. 19 Pool

Co. Farm

S-513-B

County Marion Elev.

Sec. 9 Twp. 19 Rge. 4E

Company J. T. Hannah

Farm Name McCarty No. 1

TOPS	DEPTH	LOG	DATUM
Anh.			
Tp.			
H.			
Tr.			
Dg.			
B. L.			
L.			
K.C.			
B.K.C.			
Ce.			
C.	2343		
M.			
M.			
K.			
Mz.			
Mq.			
V.			
S.			
S.			
A.			
R.			
Pf.			
G.			
T.D.			

Loc. in Sec. NE SE SW

Geol.

Contr. Midwest #2

Pool Quarry Siding

AUG 13 58
FIRST REPORT
0

Date Comm. 8-5-58

8" @ 128 w/100, DST 2366-86 1 hr, GTS-3"-600' oil & 180 OCM & 300' SW, RTD 2388, 5" @ 2368

Co. Lse. No. Sec. T. R.

CORRECTION

Twp.____ Pool____

Co.____ Facet____

S-513-B

County Marion Elev 1384DF 1387KB

Sec. 9 Twp. 19 Rge. 4E

Company J. T. Harman

Farm Name McCarty No. 1

TOPS	DEPTH	LOG	DATUM
Anh.			
Tp.			
H.			
Tr.			
Dg.			
B.L.			
L.			
K.C.			
B.K.C.			
Ce.			
C.			
M.	2343		
M.			
K.			
Mz.			
Mq.			
V.			
S.			
S.			
A.			
R.			
Pf.			
G.			
T.D.			

Loc. in Sec. ~~NE SE SW~~ NW SE SW

Geol.

Contr. Midwest #2

Pool Quarry Siding

COMPLETE

SEP 17 '58

Date Comm. 8-5-58

8" @ 128 w/100, DST 2366-86 1 hr, GTS-3"-600' oil & 180 OCM & 300' SW, RTD 2388, 5" @ 2368 AUG 20 '58 AUG 27 '58 DD 2393

Swb 35 BO 30 BW 8 hr. T. 4 SEP 3 '58

½ SEP 10 '58 frac POP SEP 17 '58

P 48 BO 150 BW 24 hrs

Co. Lse. No. Sec. T. R.