


SECTION 19 TOWNSHIP 8S RANGE 17^W

WELL NO. #3 Reeder

COMPANY Cities Service

NORTH S/2 N/2 SE

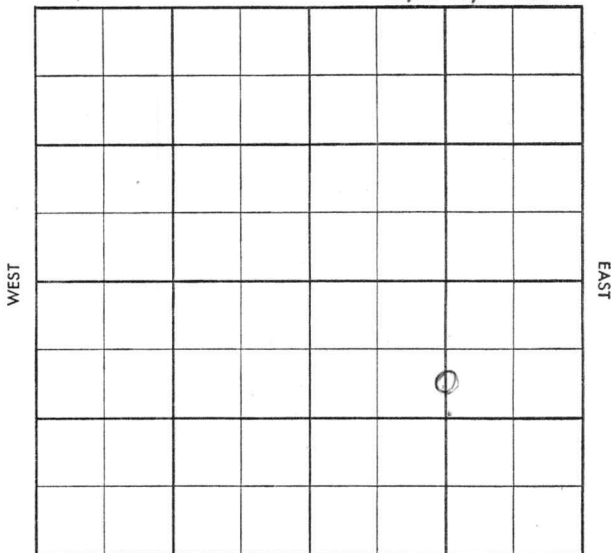

SOUTH

~~Telephone Pool~~
~~Gasoline Pool~~

County Rooks Elev. _____
Sec. 19 Twp. 8 Rge. 17W
Company Cities Service
Farm Name Reeder No. 3

TOPS	DEPTH	LOG	DATUM
Anh.			
Tp.			
H.			
Tr.			
Dg.			
B.L.			
L.			
K.C.			
B.K.C.			
Ce.			
C.			
M.			
M.			
K.			
Mz.			
Mq.			
V.			
S.			
S.			
A.			
R.			
Pf.			
G.			
T.D.			

Loc. in Sec. _____

S $\frac{1}{2}$ N $\frac{1}{2}$ SE

Geol. _____

Contr. _____

Lohman & Johnson
Pool _____

Elm Creek



Date Comm. _____

Location

Co.
Lse.
No.
Sec.
T.
R.

Twp. X Pool X
 Co. X Facet X

9-513-B

County Rooks Elev 19210F 193480
 Sec. 19 Twp. 8 Rge. 17W
 Company Cities Service
 Farm Name Reeder No. 3

TOPS	DEPTH	LOG	DATUM
Anh.	<u>1256</u>		
Tp.	<u>2856</u>		
H.			
Tr.	<u>3061</u>		
Dg.			
B.L.			
L.	<u>3079</u>		
K.C.			
B.K.C.			
Ce.			
C.			
M.			
M.			
K.			
Mz.			
Mq.			
V.			
S.			
S.			
A.	<u>3345</u>		
R.			
Pf.			
G.			
T.D.	<u>3346</u>		

Loc. in Sec. S¹/₂ N¹/₂ SE
 Geol. _____
 Contr. _____
Lohman & Johnson
 Pool Elm Creek



Date Comm. 5-26-58 8" 240/175
 Location 22910

JUN 11 '58 DST 3040-70 1hr 93' Hogem
94' MCO 105' oil BHP 1170-910/30"
DST 3080-3106 1hr 45' MCO BHP 1000
-1140/30" DST 3117-76 1hr 27' 50cm BHP
0-180/30" DST 3174-95 1hr 136' M 65W BHP
1120-1030/30" DST 3235-75 1hr 25'
V 40cm 20' 50cm BHP 1140-1060/30"
DST 3309-33 8 1hr 17' M BHP 30/30" 5"
3346/175. W OCT JUN 18 '58

Co.
 Twp.
 Rge.
 Sec.
 No.
 T.
 R.

DD 3355 Δ p 24B0 $\frac{1}{2}$ BW 24hrs

JUN 25 58 DD 3363 TD Δ P 51B0

4BW 24hrs

Arb 3346-63

ϕ

19-8-17W

5 $\frac{1}{2}$ 5 $\frac{1}{2}$ se