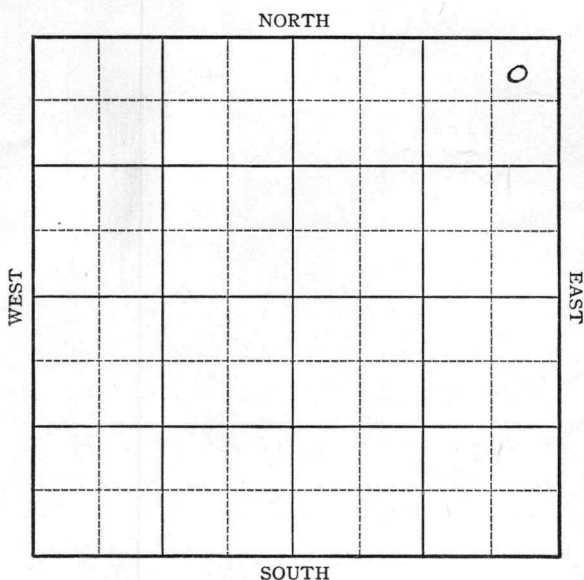


KANSAS

FORM 51 5M 1-42 PETROL

Rooks

Section 33 Township 8 Range 18-WWell No. #1 ~~#4 Street~~ WELCHCompany Continental

KANSAS


Rooks

Sec. 33 Twp. 8 R. 18-W

Well No. #4 Strat #1 Welch Farm

Continental Company

NORTH

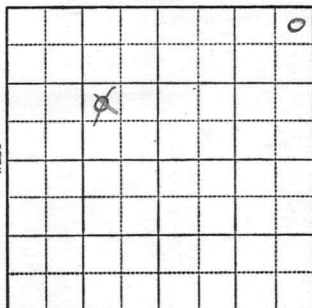

330 Ft. from N. Line

Ft. from S. Line

330 Ft. from E. Line

Ft. from W. Line

O.W.W.O.

1943

Elev. 1966

R E P O R T

11/10

Anhy. 1327
Topeka 2891
Lansing 3131
Cong. 3385
Arb. 3438
SO 3282-3320
Capped
T.D. 3452'

FIRST REPORT



ABANDONED

1943

O.W.W.O.

12/22

Derrick (Old Strat Test)

12/29

"

1944

1-5

"

1-12

Anhy 1323
Topeka 2887
Lans 2127
Arb 3434-48 TD
Run csg.

1-19

5" @ 3350 RUST

1/26

38 shots 3279-3317-1800' water in
12 hrs
PB 3220
WOC.

OVER

1944

2/2

PB 3237-36 shots 3209-21
2700' oil swab 80 oil in 5 hrs.

2/9

Topeka 2887

Lans 3127

Arb 3434

5" @ 3350

TD 3448

~~PR~~ 3237

36 shots 3209-21

Acid 3000 Pump 708 Pot.

Gravity 37

COMPLETED

KANSAS

Map No. 62 Sec. 33 Twp. 8 R. 18WWell No. 4 Strat

Continental

Company

FIRST REPORT

Contractor

NE/C ABANDONED

SECTION PLAT

330


Ft. from N. Line

Ft. from S. Line

330

Ft. from E. Line

Ft. from W. Line

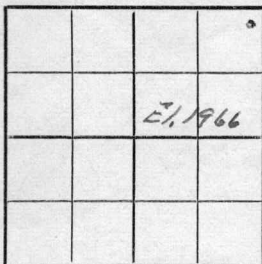

Wildcat

Location

Rig up

Drilling and Remarks:

Anhy. 1327

Topeka 2891

Lansing 3131

Cong. 3385

Arb. 3438

SO 3282-3320

Capped

RECORD

Cased _____ in., _____ ft.

Sand _____

Gas _____

Oil _____

Total Depth 3452

PRODUCTION

1st 24 hrs. Nat. _____

1st 24 hrs. after shot _____

Gas _____ Cu. Ft.

Dry Hole _____

Abandoned _____

Date

NOV 10 1943

19

S. J. LEWIS

Scout

KANSAS

Map No. 64 Sec. 33 Twp. 8 R. 18W

Well No. 1 Welch

Continental


Company

FIRST REPORT

Contractor

NE/C

SECTION PLAT

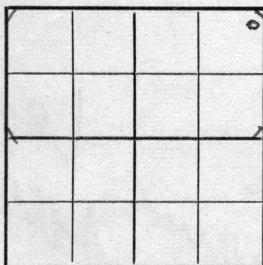

330 Ft. from N. Line

Ft. from S. Line

330 Ft. from E. Line

Ft. from W. Line

W. W. O.

Wildcat

Location

Rig up

Drilling and Remarks:

Derrick

Old Strat Test

Correct Well
From #4 to #1

RECORD

Cased _____ in., _____ ft.

Sand _____

Gas _____

Oil _____

Total Depth _____

PRODUCTION

1st 24 hrs. Nat. _____

1st 24 hrs. after shot _____

Gas _____ Cu. Ft.

Dry Hole _____

Abandoned _____

Date

DEC 22 1943

19

S. J. LEWIS

Scout

Our records show this well as #4 Strat.
Please let us have a correction ticket.

Test hole
Same same dry hole

TD 3452

Misc. Small Map	
Cards	Madge
Tracing	MEZ
France Map	4
Scarborough Map	
Moody Map	
Geological Dept.	
Moody Plat. Book	

This was the #4 Strat.
test.

Have built a derrick
on the same location.

and call it #1 the 1st.

They will run the hole
set 5 pipe and try and
make an oil well

Sandy

KANSAS

Map No. 67 Sec. 33 Twp. 8 R. 18WWell No. 1 WelchContinental


Company

COMPLETED

Contractor

NE/C

SECTION PLAT

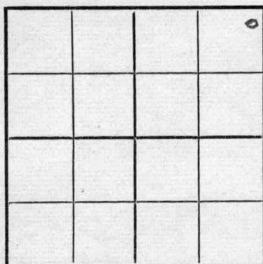330 Ft. from N. Line Ft. from S. Line330 Ft. from E. Line Ft. from W. Line

Wildcat Old #4 Strat test

Location Rig up

Drilling and Remarks:


Date

RECORD

Cased in., ft.Sand Gas Oil Total Depth 3448

PRODUCTION

1st 24 hrs. Nat. 1st 24 hrs. after shot Gas Cu. Ft.Dry Hole Abandoned

FEB 9 1944 19

S. J. LEWIS

Scout