


Map No. **KANSAS** Sec. 22 Twp. 27 R. 5^E
 Well No. 10-A" m^o Gray Farm
Empire Oil Company

240 Ft. from N. Line

_____ Ft. from S. Line

240 Ft. from E. Line

_____ Ft. from W. Line

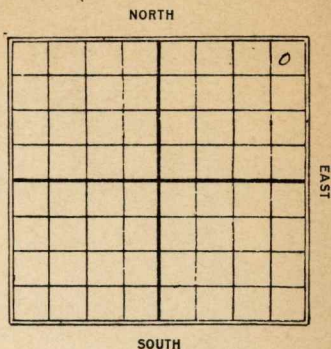

Date

REPORT

~~Here~~

8/13	Bldg rig
8/20	Spdy.
8/27	Wrlg. 950'
9/3	10" L 1875'
	Wrlg. 1925'
9/10	" 2425'
9/17	Land 2743-72
	TD 2775
	shot 90 qt
	175 bbl oil
	Comp.

Butler

Map No. **KANSAS** Sec. 22 Twp. 27 R. 5^E
 Well No. 10 'H' Mc Cray
Empire O & R Co Company
 Contractor

FIRST REPORTS240 Ft. from N. Line

_____ Ft. from S. Line

240 Ft. from E. Line

_____ Ft. from W. Line

SECTION PLAT

			5

Location _____

Rig up _____

Drilling and Remarks:

1 acre out of
NE/4 for school,
Well being drilled
on it.

RECORD

Cased _____ in., _____ ft.

Sand _____

Gas _____

Oil _____

Total Depth _____

PRODUCTION

1st 24 hrs. Nat. _____

1st 24 hrs. after shot _____

Gas _____ Cu. Ft.

Dry Hole _____

Abandoned _____

Date

AUG 13 1930**CHAS. L. SHERWOOD**19

Scout

11
 Map No. **KANSAS** Sec. 22 Twp. 27 R. 5
 Well No. 10 McCray
Empire Oil & Gas Co
 Company
 Contractor

COMPLETE240 Ft. from N. Line

_____ Ft. from S. Line

240 Ft. from E. Line

_____ Ft. from W. Line

SECTION PLAT

			o

Location _____

Rig up _____

Drilling and Remarks:

90/175 Blk**RECORD**

Cased _____ in., _____ ft.

Sand 2743-2772

Gas _____

Oil _____

Total Depth 2775**PRODUCTION**

1st 24 hrs. Nat. _____

1st 24 hrs. after shot _____

Gas _____ Cu. Ft.

Dry Hole _____

Abandoned _____

Date

SEP 17 1930

19

CHAS. L. SHERWOOD

Scout