

Marion


KANSAS

SECTION 15 TOWNSHIP 19 RANGE 4E

WELL NO. #2 Thies

COMPANY C.H. Spore, Jr.

NORTH NW SW NW

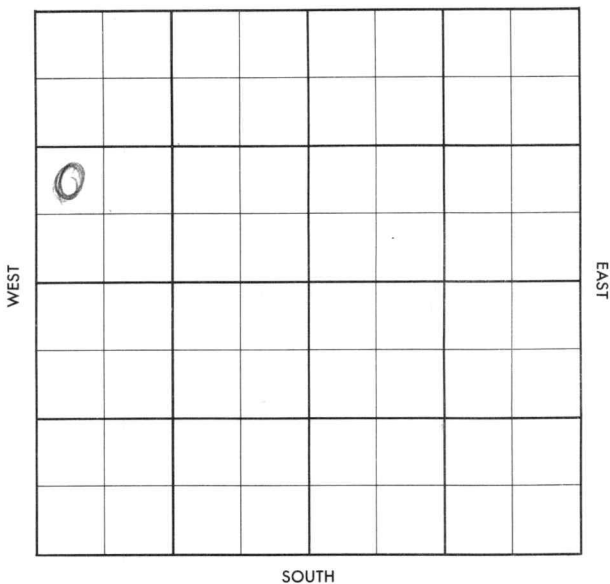

County Marion Elev. \_\_\_\_\_  
 Sec. 15 Twp. 19 Rge. 4E  
 Company C. H. Spore, Jr.  
 FarmName Thies No. 2

| TOPS   | DEPTH | LOG | DATUM | Loc. in Sec.  |  |  |  |  |  |  |  |  |  |  |  |  |  |  |  |  |  |  |
|--------|-------|-----|-------|---|--|--|--|--|--|--|--|--|--|--|--|--|--|--|--|--|--|--|
| Anh.   |       |     |       | NW SW NW  |  |  |  |  |  |  |  |  |  |  |  |  |  |  |  |  |  |  |
| TP.    |       |     |       |   |  |  |  |  |  |  |  |  |  |  |  |  |  |  |  |  |  |  |
| H.     |       |     |       |   |  |  |  |  |  |  |  |  |  |  |  |  |  |  |  |  |  |  |
| Tr.    |       |     |       |   |  |  |  |  |  |  |  |  |  |  |  |  |  |  |  |  |  |  |
| Dg.    |       |     |       | Geol. _____<br>Contr. _____<br>Berentz<br>Pool<br>Quarry Siding   |  |  |  |  |  |  |  |  |  |  |  |  |  |  |  |  |  |  |
| Bl.    |       |     |       |   |  |  |  |  |  |  |  |  |  |  |  |  |  |  |  |  |  |  |
| L.     |       |     |       |   |  |  |  |  |  |  |  |  |  |  |  |  |  |  |  |  |  |  |
| K.C.   |       |     |       |   |  |  |  |  |  |  |  |  |  |  |  |  |  |  |  |  |  |  |
| B.K.C. |       |     |       |   |  |  |  |  |  |  |  |  |  |  |  |  |  |  |  |  |  |  |
| Ce.    |       |     |       |   |  |  |  |  |  |  |  |  |  |  |  |  |  |  |  |  |  |  |
| C.     |       |     |       |   |  |  |  |  |  |  |  |  |  |  |  |  |  |  |  |  |  |  |
| M.     |       |     |       |   |  |  |  |  |  |  |  |  |  |  |  |  |  |  |  |  |  |  |
| M.     |       |     |       |   |  |  |  |  |  |  |  |  |  |  |  |  |  |  |  |  |  |  |
| K.     |       |     |       |   |  |  |  |  |  |  |  |  |  |  |  |  |  |  |  |  |  |  |
| Mz.    |       |     |       | <table border="1"> <tr><td></td><td></td><td></td></tr> <tr><td></td><td></td><td></td></tr> <tr><td></td><td></td><td></td></tr> <tr><td></td><td></td><td></td></tr> <tr><td></td><td></td><td></td></tr> <tr><td></td><td></td><td></td></tr> </table> |  |  |  |  |  |  |  |  |  |  |  |  |  |  |  |  |  |  |
|        |       |     |       |   |  |  |  |  |  |  |  |  |  |  |  |  |  |  |  |  |  |  |
|        |       |     |       |   |  |  |  |  |  |  |  |  |  |  |  |  |  |  |  |  |  |  |
| Mq.    |       |     |       |   |  |  |  |  |  |  |  |  |  |  |  |  |  |  |  |  |  |  |
| V.     |       |     |       |   |  |  |  |  |  |  |  |  |  |  |  |  |  |  |  |  |  |  |
| S.     |       |     |       |   |  |  |  |  |  |  |  |  |  |  |  |  |  |  |  |  |  |  |
| S.     |       |     |       |   |  |  |  |  |  |  |  |  |  |  |  |  |  |  |  |  |  |  |
| A      |       |     |       |   |  |  |  |  |  |  |  |  |  |  |  |  |  |  |  |  |  |  |
| R.     |       |     |       |   |  |  |  |  |  |  |  |  |  |  |  |  |  |  |  |  |  |  |
| PC.    |       |     |       |   |  |  |  |  |  |  |  |  |  |  |  |  |  |  |  |  |  |  |
| G.     |       |     |       |   |  |  |  |  |  |  |  |  |  |  |  |  |  |  |  |  |  |  |
| T.D.   |       |     |       |   |  |  |  |  |  |  |  |  |  |  |  |  |  |  |  |  |  |  |

FIRST REPORT  
 JUL 7 '57

Date Comm. \_\_\_\_\_  
 Location \_\_\_\_\_

\_\_\_\_\_  
 \_\_\_\_\_  
 \_\_\_\_\_  
 \_\_\_\_\_  
 \_\_\_\_\_  
 \_\_\_\_\_  
 \_\_\_\_\_  
 \_\_\_\_\_

Co.  
Lse.  
No.  
Sec.  
T.  
R.

County Marion Elev. \_\_\_\_\_  
 Sec. 15 Twp. 19 Rge. 4E  
 Company C. H. Spore, Jr.  
 Farm Name Thies No. 2

Co.

| TOPS   | DEPTH       | LOG | DATUM |
|--------|-------------|-----|-------|
| Anh.   |             |     |       |
| Tp.    |             |     |       |
| H.     |             |     |       |
| Tr.    |             |     |       |
| Dg.    |             |     |       |
| Bl.    |             |     |       |
| L.     |             |     |       |
| K.C.   | <u>1726</u> |     |       |
| B.K.C. |             |     |       |
| Ce.    |             |     |       |
| C.     |             |     |       |
| M.     | <u>2253</u> |     |       |
| M.     |             |     |       |
| K.     |             |     |       |
| Mz.    |             |     |       |
| Me.    |             |     |       |
| V.     |             |     |       |
| S.     |             |     |       |
| S.     |             |     |       |
| A.     |             |     |       |
| R.     |             |     |       |
| Pe.    |             |     |       |
| G.     |             |     |       |
| T.D.   | <u>2277</u> |     |       |

Loc. in Sec. \_\_\_\_\_  
NW SW NW  
 Geol. \_\_\_\_\_  
 Concr. \_\_\_\_\_  
Berentz  
 Pool \_\_\_\_\_  
Quarry Siding

Lse.

|            |  |
|------------|--|
| SEP 11 '57 |  |
|            |  |
| COMPLETE   |  |

No.

Date Comm. 7-15-57  
 Location JUL 24 '57 8<sup>5</sup>/<sub>8</sub> @ 150/150  
w/spodden 5 1/2 2275/50 WOCT  
JUL 31 '57 AUG 8 '57 AUG 14 '57 ~~20/2278~~ AUG 21 '57  
AUG 28 '57 ✓ SEP 4 '57 ✓ SEP 11 '57 20/2268-73  
FU 1100 Rd frac p 25 Di  
30 BW pd in MISS

Sec.

T.

R.