
FORM 51 25M 8-50 WESTERN Marion

O.W.D.D
KANSAS

Section 8 Township 19 Range 4 E

Well No. # 1 Propp

Company ~~Mendenhall Drlg. et al~~ H. Ratzlaff

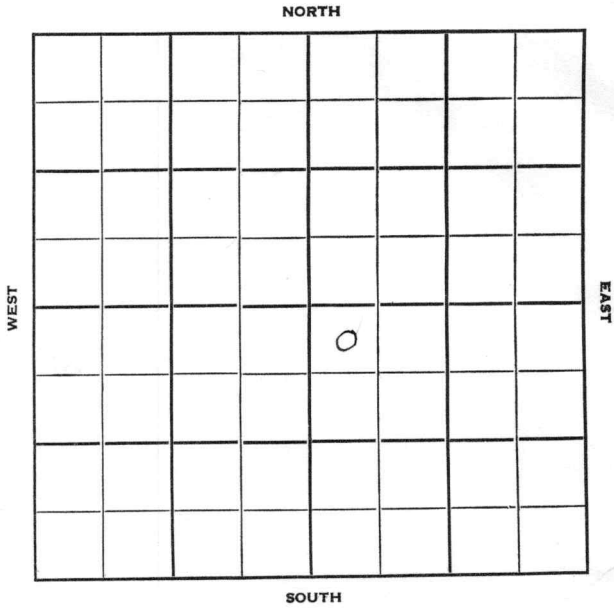

FORM 252-B
10M 11-50 PETROL

O.W.D.D Marion KANSAS

Sec. 8 Twp. 19 R. 4 E ✓ ✓

Well No. # 1 Propp Farm

~~Mendenhall Drlg. et al~~ Ratzlaff Company

Contractor

Propp Pool


330 Ft. from N. Line

Ft. from S. Line

Ft. from E. Line

330 Ft. from W. Line

NW NW SE

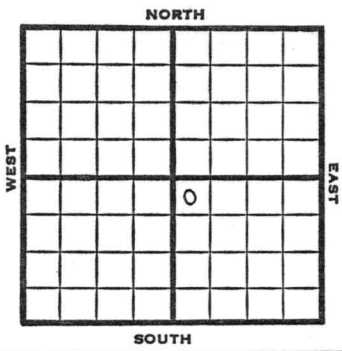

1951	Elev. 1417' REPORT
4/18	R U R
5/16	Spud 4-17-51 Gas well TD 2395' 8" @ 115 KC 1820' Mar. 2178' Miss 2360-63' 4½" @ 2360' TD 2381' gas 2362-66' Test 100,000 CFG DD 2395' SP 2369½ Comp. 200,000 CFGPD COMPLETED O.W.D.D
1953	
3/11	Miss 2360 4" @ 2360 OTD 2395 Comp. for gas well to DD
7/1	D & A TD 2409 Miss 2360 4" @ 2360 OTD 2395 DD 2408 FU 1800' oil 8 hr. 10 qt/2399-2408 CO to 2409 P/2 BO 8 BWPD P/100 BO 30 days. D & A ABANDONED

FORM 275 FOR SALE BY KANSAS BLUE PRINT CO.


County Marion State Kansas

Sec. 8 (Blk. Twp.) 19 (Sur. Rge.) 4E Map No.

Operator Mendenhall Drlg. etal.

Well No. 1 Farm Propp

Elev. Location NW NW SE

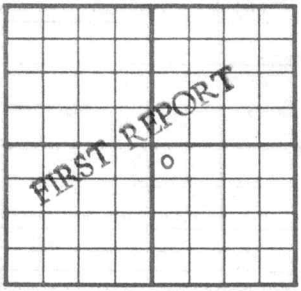

330 Ft. From N Line SE

330 Ft. From W Line Quarter

1st. Report APR 18 1951

Completion

Remarks

Spudding Date

Drlg. Data Propp Pool

R U R

J. E. TYRA

FORM 275 FOR SALE BY KANSAS BLUE PRINT CO.


County Marion State Kansas

Sec. 8 (Blk. Twp.) 19 (Sur. Rge.) 4E Map No.

Operator Mendenhall Drlg. etal.

Well No. 1 Farm Propp

Elev. 1417 Location NW NW SE

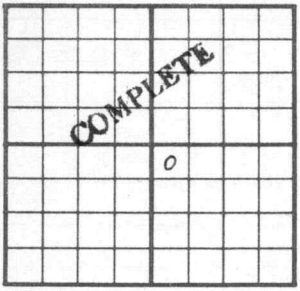

330 Ft. From N Line SE

330 Ft. From W Line Quarter

1st. Report

Completion MAY 16 1951

Remarks Propp Pool

Spudding Date 4-17-51

Drlg. Data Gas well TD 2395

8" @ 115 KC 1820 Mar. 2178

Miss. 2360-63 4½" @ 2360 TD 2381

gas 2362-66 test 100,000 cfg DD 2395

SP 2369½ Comp. 200,000 cfgpd

J. E. TYRA

FORM 275 FOR SALE BY KANSAS BLUE PRINT CO.

O.W.D.D

County Marion State Kansas

Sec. 8 (Blk. Twp.) 19 (Sur. Rge.) 4E Map No.

Operator H. Ratzlaff

Well No. 1 Farm Propp

Elev. 1417 Location NW NW SE



330 Ft. From N Line SE

330 Ft. From W Line Quarter

1st. Report MAR 11 1953

Completion MAR 11 1953

Remarks OWDD

J. W. D. D.

Spudding Date

Drlg. Data

Miss. 2360 4" @ 2360 OTD 2395

Comp. for gas well to DD

J. G. McGEHEE

FORM 275 FOR SALE BY KANSAS BLUE PRINT CO.

O. W. D. D


County Marion State Kansas

Sec. 8 (Blk. Twp.) 19 (Sur. Rge.) 4E Map No.

Operator H. Ratzlaff

Well No. 1 Farm Propp

Elev. 1417 Location NW NW SE

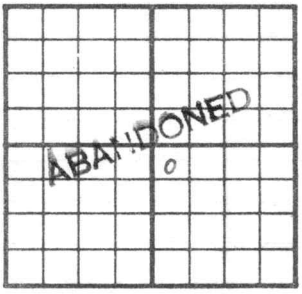

330 Ft. From N Line SE

330 Ft. From W Line Quarter

1st. Report

Completion JUL 1 1953

Remarks OWDD

O. W. D. D

Spudding Date

Drlg. Data D & A TD 2409

Miss. 2360 4" @ 2360 OTD 2395

DD 2408 FU 1800' oil 8 hr.

10 qt/ 2399-2408 CO to 2409

P/ 2 bo 8 bwpd P/ 100 bo 30 days

D & A

J. G. McGEHEE