

DX 78-1

Marion KANSAS


O. W. P. B.

Section 8 Township 19 Range 4E

Well No. 1 Propp Guy "B"

Company H. B. Ratzlaff

NORTH

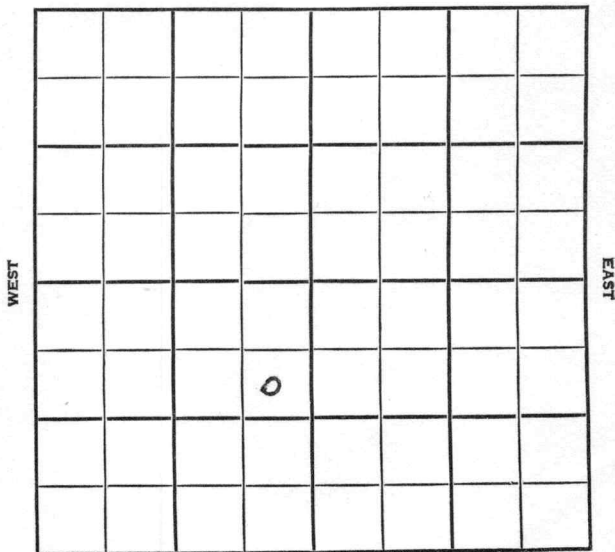

SOUTH

Marion KANSAS

SEC. 8 TWP. O. W. P. B. R. 4E
19

WELL NO. 1 Propp Guy "B" FARM

COMPANY H. B. Ratzlaff

CONTRACTOR Berentz


Propp Pool

990 Ft. from N. Line

Ft. from S. Line

330 Ft. from E. Line

Ft. from W. Line

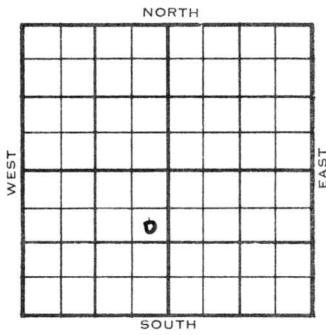

SE NE SW

1954 ELEVATION 1421' REPORT

8/11

8" @ 109'

8/25

Spud 8-9-54 - D&A
 TD 2882'
 8" @ 109'
 Br. Lime 1755', Lans 1830', KC 2186',
 Miss 2365', Miss Lime 2413', Kh. 2502,
 Chat sh 2699', Misener 2706', Maq.
 2733', Viola 2758', Simp. dol 2850',
 Simp.sd 2853'
 TD 2882'
 D&A

2733
 2365
 368

ABANDONED

1955

O. W. P. B.

4/6

Miss 2365' Miss Lime 2413'
 Viola. 2758', Simp dol. 2850', Simp
 Sd. 2853'
 OTD 2882'
 to CO & set pipe to test Simp
 & Miss.

OVER

1955
4/13

D & A TD 2942' Miss 2365'
Miss lime 2413' Viola 2758'
Simp. dol. 2850' Simp sd. 2853'
OTD 2882' Arb. 2904' TD 2942'
D & A

ABANDONED

County **Marion** **O. W. P. B.** State **Kansas**

Sec. **8** (Bik. Twp.) **19** (Sur. Rge.) **4E** Map No.

Operator **H. B. Ratzlaff etal.**

Well No. **1** Farm **Propp-Guy "B"**

Elev. **1421** Location **SE NE SW**

990 Ft. From **N** Line **SW**

330 Ft. From **E** Line **Quarter**

Ist. Report **APR 6 1955**

Completion

Remarks **O. W. P. B.** **OWPB**

O. Berentz - Contr.

Spudding Date

Drlg. Data **Propp Pool**

Miss. 2365 Miss. lime 2413 Viola 2758

Simp. dol. 2850 Simp. sd. 2853

OTD 2882 to CO & set pipe to test Simp. and Miss.

FABEN GILSTRAP

County Marion State Kansas

Sec. 8 (Blk. 19 (Sur. 4E Map No. (Twp.))

Operator H. B. Ratzlaff et al.

Well No. 1 Farm Propp-Guy "B"

Elev. 1421 Location SE NE SW

ABANDONED					

990 Ft. From N Line SW

330 Ft. From E Line Quarter

1st. Report

Completion APR 13 1955

Remarks Propp Pool

Berentz - Contr.

Spudding Date OWPB

Drig. Data D & A TD 2942

Miss. 2365 Miss. lime 2413 Viola 2758

Simp. dol. 2850 Simp. sd. 2853

OTD 2882 Arb. 2904 TD 2942

D & A

FABEN GILSTRAP