


Section 24 Township 27 Range 5E

Well No. #1 Ona Alley

Company Cromwell & Lewis

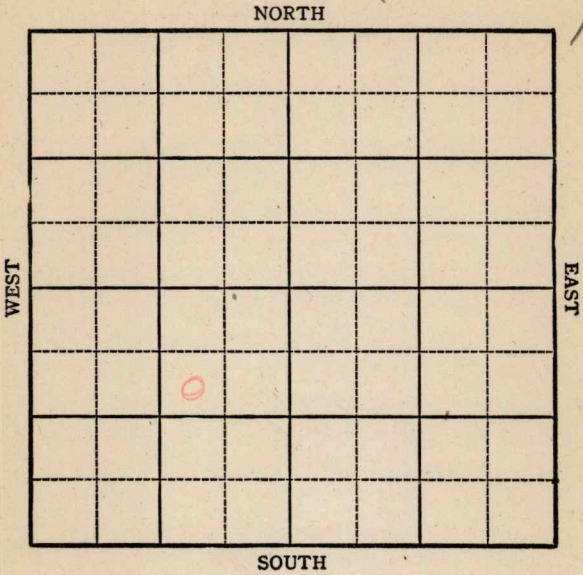

Butter Co.

Miscellaneous

KANSAS

Sec. 24 Twp. 27 R. 5E

Well No. 1 Ona Alley Farm

Cromwell & Lewis Company


SW NE SW

990 Ft. from N. Line

Ft. from S. Line

990 Ft. from E. Line

Ft. from W. Line

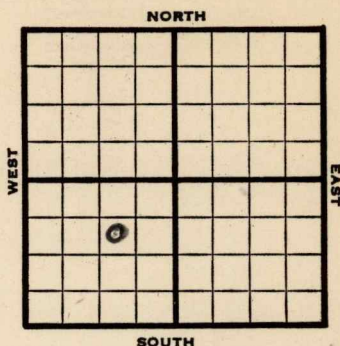

SOUTH

1944

REPORT

9-13 Location

9/21 Spud

9/28 Drlg. 815

10/4 15" @ 125

Drlg. 1430

10/11 10" @ 1520

Drlg. 2160

10/18 **KC 2165**

BKC 2270

2410 Run 8"

10/25 8" @ 2447

Miss 2760

Drlg. 2965

11/1

Viola 3153

Td 3167

HFW

ABANDONED


KANSASPool Name MiscellaneousMap No. 11 Sec. 24 Twp. 27 R. 5EWell No. 1 Ona AlleyCromwell & Lewis

Company

FIRST REPORT

Contractor

SW NE SW

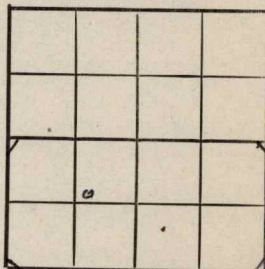SECTION PLAT990 Ft. from N. Line Ft. from S. Line990 Ft. from E. Line Ft. from W. LineButlerLocation XRig up

Drilling and Remarks:

RECORDCased in., ft.Sand Gas Oil Total Depth **PRODUCTION**1st 24 hrs. Nat. 1st 24 hrs. after shot Gas Cu. Ft.Dry Hole Abandoned

Date


SEP 13 194419S. J. LEWIS Scout

Pool Name MiscellaneousMap No. 11 Sec. 24 Twp. 27 R. 5EWell No. 10 na AlleyCromwell & Lewis CompanyABANDONED

Contractor

SWNE SW

SECTION PLAT

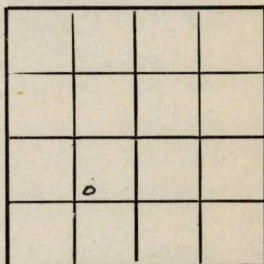990 Ft. from N. Line Ft. from S. Line990 Ft. from E. Line Ft. from W. LineButlerLocation Rig up

Drilling and Remarks:

Viola 31534 FW

RECORD

Cased in., ft.Sand Gas Oil Total Depth 3162

PRODUCTION

1st 24 hrs. Nat. 1st 24 hrs. after shot Gas Cu. Ft.Dry Hole Abandoned

Date

NOV 1 1944 19 S. J. LEWIS Scout