


Section 28 Township 18 Range 21W

Well No. 1 Cranston

Company Welch & Olsson

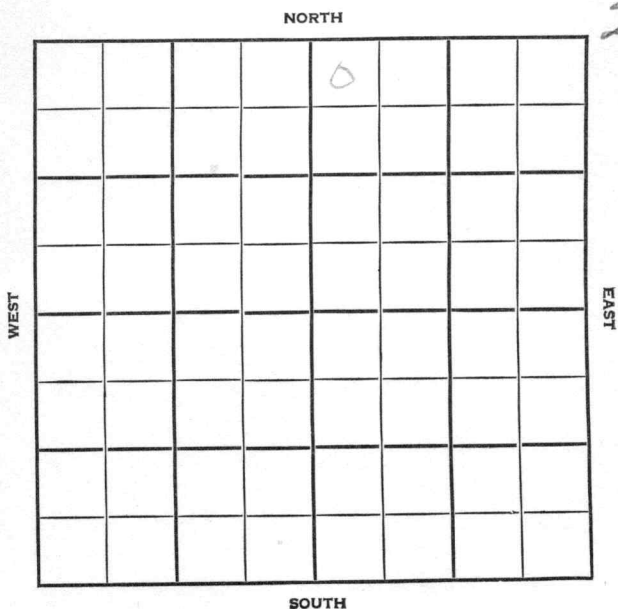

Ness

KANSAS

SEC. 28	TWP. 18S	R. 24W
------------	-------------	-----------

WELL NO.

#1 Cranston

FARM

COMPANY

Welch & Olsson

CONTRACTOR

W.C.

_____ Ft. from N. Line


_____ Ft. from S. Line

_____ Ft. from E. Line

_____ Ft. from W. Line

NW NWNNE

Stano. DHM

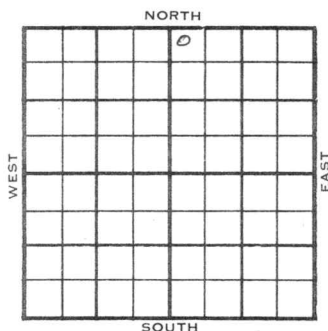


FIRST REPORT

1955	ELEVATION 2292	REPORT
7/13		Spud: 7-9-55 8" 208 w/175sx/ D 2460
7/27		DST 3922-41 open 1 hr. Rec. 30' vso & gcm 60' wtry mud 1300/20" DST 4297- 4305 open 45 min. Rec. 30' drlg mud 1220/45 DST 4305-15 so & gcm 4' freeoil 1230/45" DS ¹ 4315-30 open 1 hr. Rec. socmsw 200' sw 1070/45" D&A
		H. 3671 3670 1378
		Tr. 3689 1397
		L. 3711 3713 1421
		BKC 4034 1742
		Ca. Sh. 4290 4213 1921
		De. sd 4296 2004
		M. 4318 4315 2023
		TD. 4370

ABANDONED

County Ness Elev. _____
 Sec. 28 Twp. 18S Rgs. 24W
 Company Welch & Olsson
 Farm Name Cranston No. 1

TOPS	DEPTH	LOG	DATUM
Anh.			
Tp.			
H.			
Tr.			
Dg.			
Bl.			
L.			
K.C.			
B.K.C.			
Ce.			
C.			
M.			
M.			
K.			
Mz.			
Ma.			
V.			
S.			
S.			
A.			
R.			
PE.			
G.			
T.D.			

Loc. in Sec. _____
NW NW NE
Stano. DHM
 Geol. _____
 Contr. _____
 Pool _____
W.C.

 JUL 13 55
 FIRST REPORT

Date Comm. spud 7-9-55; 8" 208 w/175 sx;
D 2460

18

Co.
Lse.
T.
R.

County Ness Elev. 2292
 Sec. 28 Twp. 18 Rge. 24W
 Company Welch & Olsson
 Farm Name Cranston No. 1

Co.

TOPS	DEPTH	LOG	DATUM
Anh.			
T.P.			
H.	3671	3670	1378
Tr.		3689	1397
Dg.			
Bl.			
L.	3711	3713	1421
K.C.			
B.K.C.		4034	1742
Ce. <i>sh</i>	4290	4213	1921
Ce. <i>sd</i>	4296		2004
M.	4318	4315	2023
M.			
K.			
Mz.			
Mq.			
V.			
S.			
S.			
A.			
R.			
PE.			
G.			
T.D.	4370		

Loc. in Sec. NW NW NE

Geol. _____

Contr. _____

Pool Wildcat



Lse.

No.

Sec.

T.

R.

Date Comm. 7-9-55 JUL 27 1955
8" @ 208/175 DST 3922-41 open 1 hr.
Rec. 30' vso & gcm 60' wtry mud
1300/20" DST 4297-4305 open 45 min.
Rec. 30' drlg. mud 1220/45⁵ DST 4305-
15 open 45 min. Rec. 15' mud
15' so & gcm 4' free oil 1230/45"
DST 4315-30 open 1 hr. Rec. socmsw
200' sw 1070/45"

D & A