
WH8-DC8 Ness KANSAS

SECTION 11 TOWNSHIP 18S RANGE 24W

WELL NO. #1 Floyd

COMPANY Rex & Morris, etal

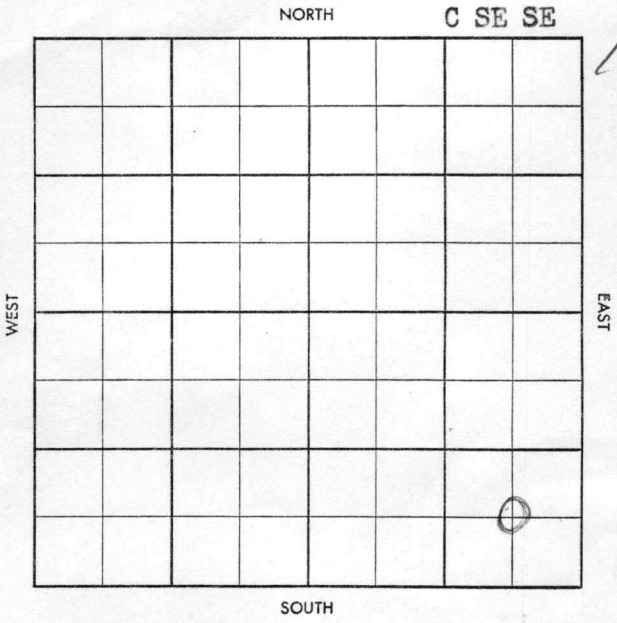

FORM 504-3 SUNRAY

HOT FILE Ness KANSAS


SEC.	TWP.	R.
11	18 S	24 W

WELL NO. # 1 Floyd FARM

COMPANY W.H. Rex & J. E. Morris et al

CONTRACTOR Co. Tools

Wildcat

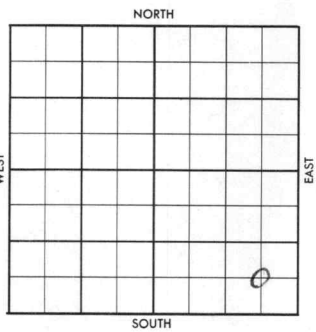

_____ FT. FROM N. LINE

_____ FT. FROM S. LINE

_____ FT. FROM E. LINE

_____ FT. FROM W. LINE

SE SE

Pan-Am-AC

SDX-FO (S-17838) -DHM

	ELEVATION
1958	2322' RB, 2319' REPORT (WH8-DC8) ✓

3/13 To be drilled to a depth sufficient to penetrate 25' into the Miss. Lime at appx 4400'
To be commenced by April 25, 1958
To be completed by May 25, 1958
(See copy FO Agrt 3-12-58)

4/9 MIRT (FR Tkt)

4/17 Spud 4-13-58
8-5/8" @ 346/175
Drlg. 1625' (WH-Wkly Drlg. Rpt)

4/24 NR "

4/30 Circ. @ 4410'. Ran log. No shows.
TD 4470' Log TD 4469' D & A -4-23-58
Tops: H. 3707', Tr. 3733', L. 3752'
BKC 4093', Ft. Scott 4256', Ce Sh 4333', M. Dol 4351'
(Scout Completion Ticket)

ABANDONED

5/23 (Advised Contract Section- D & A) ✓

FORM 504-5 SUNRAY

Twp. X Pool X

Field X 18

WILDCAT

S-513-B

Co.

County Ness Elev.

Sec. 11 Twp. 18 Rge. 24W

Company Rex & Morris etal

Farm Name Floyd No. 1

TOPS	DEPTH	LOG	DATUM
Anh.			
Tp.			
H.			
Tr.			
Dg.			
B.L.			
L.			
K.C.			
B.K.C.			
Ce.			
C.			
M.			
M.			
K.			
Mz.			
Mq.			
V.			
S.			
S.			
A.			
R.			
Pf.			
G.			
T.D.			

Loc. in Sec. C SE SE

(WH 8-DC 8)

Geol.

Contr. Co. Tools

Lse.

Pool Wildcat



No.

Date Comm. (SMC - DHM)Pan Am-Ac)

MIRT

Sec.

T.

R.

APR 11 1958

M. M.

MAY 5 1958

M. M.

Twp. Pool

Co. Facet

S-513-B

County Ness Elev. 2322 RB 2317

Sec. 11 Twp. 18 Rge. 24W

Rex & Morris etal

Floyd No. 1

TOPS	DEPTH	LOG	DATUM
Anh.		3403	
Tp.	3707	3705	
H.	3735	3732	
Tr.			
Dg.			
B. L.	3752	3752	
L.			
K.C.	4093	4058	
B.K.C.	4256		
Ce. 7 Scott	4323		
Ce. Sh.	4351	4350	
M. Dol			
M.			
K.			
Mz.			
Mq.			
V.			
S.			
S.			
A.			
R.			
Pf.			
G.			
T.D. X	4470	4469	

Loc. in Sec. C SE SE

(WH8-DC8)

Geol.

Contr. Co. Tools

Pool Wildcat

ABANDONED

APR 30 '58

Date Comm. 4-13-58 (SMC - DHM) Pan Am-Ac)

MIRT APR 16 '58 X 8-5/8 @ 346/175

APR 23 '58 APR 30 '58

ϕ 1625 Circ @ 4410

X ran Log N0540sw

D&A

Co. Lse. No. Sec. T. R.