

O.W.W.O.


Meade KANSAS

DX 78-1

Section 32 Township 33 Range 30<sup>W</sup>

Well No. Ohio - 1 W. H. Bond

Company Lion Ohio

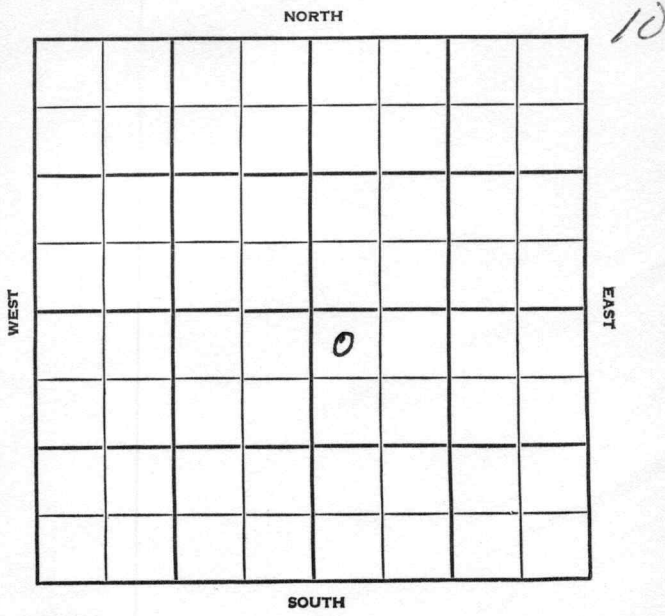

O.W.W.O.

Meade KANSAS

SEC.	TWP.	R.
32	33	30W
WELL NO. <u>6110 -</u>		
1 <del>W. H.</del> Bond		
COMPANY		FARM
<u>LION</u>		
<u>Ohio</u>		
CONTRACTOR		


Rhine Drlg.

330 \_\_\_\_\_ Ft. from N. Line

\_\_\_\_\_ Ft. from S. Line

\_\_\_\_\_ Ft. from E. Line

330 \_\_\_\_\_ Ft. from W. Line

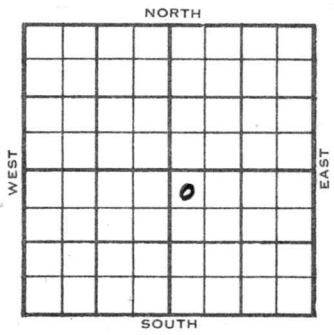

NW NW SE Miss. test

	ELEVATION	REPORT
1954	2706'	
7/7	13" @ 658	Drlg. 1650
7/21	DST 3450-3510	1 hr. 1465 wtr 925# Heeb 4392 Tor 4426 Lans. 4540 Drlg. 4609
9/29	Oil well TD 5990	13" @ 658 9-5/8" @ 2675 DST 3450-3510 open 1 hr rec 1465' wtr. 925# Heeb 4392 Tor. 4426 Lans. 4540 Marm. 5210' Cherokee 5406 DST 5615-32 open 1 1/2 hr Atoka 5605' rec 365' clean oil 1500# Morrow 5713' DST 5750-92 open 1 hr rec 295' SO & GCM 1005# Chester 5783' DST 5792-5802 open 2 hr rec 710' gas. 240' STCM 150' SW 1170# DST 5792-5807 open 2 hr rec 1100' gas, 240' GCM, 150' SW 1170# DST 5750-91 open 1 hr Schl tops: Kri. 2730 Win. 2793 Ft. Riley 2865' Florence flint 2942 Lans. 4554' Marm 5204' Cherokee 5410 Atoka 5612' Morrow 5715' Chester 5784

OVER

1954  
9/29

(Information continued)

DST 3448-3508 open 1 hr rec 1100'

SGCM, 365' SW, 925#

DST 5615-32 open  $1\frac{1}{2}$  hr gas in 35 min  
24,000 CFG, 250' clean oil, 115' OCM  
1500#

DST 5770-91 open 1 hr gas in 35 min  
rec 295' SGCM 1005#

DST 5792-5807 open 2 hr rec 710' gas,  
240' GCM, 150' SW 1170# TD 5990

5" @ 5870 CO to TD 48/5619-31

1000 A S/56 BO 12 hr.

F/6 BO 12 hr. 3000 A

S/48 BO 12 hr. F/8 BO 12 hr.

S/15 BOPH 4 hr. P/50 to 60 BOPD

Comp. 129 BOPD

**COMPLETED**

County **Meade** State **Kansas**

Sec. **32** (Blk. **33**) (Sur. **30W**) Map No.

Operator **Ohio**

Well No. **1** Farm **W. H. Bond**

Elev. Location **NW NW SE**


**330** Ft. From **N** Line **SE**  
**330** Ft. From **W** Line Quarter

1st. Report **JUL 7 1954**

Completion

Remarks **Miss. test**

**Rine Drlg. - Contr.**

Spudding Date

Drlg. Data

**13" @ 658 drlg. 1650**



Drilg. Data

Marm. 5204 Cherokee 5410 Atoka 5612

Morrow 5715 Chester 5784 DST 3448-3508

open 1 hr. Rec. 1100' sgcm 365' sw

925# DST 5615-32 open 1 1/2 hr. gas in

35 min. 24,000 cfg 250' clean oil

115' ocm 1500# DST 5770-91 open 1 hr.

Gas in 35 min. Rec. 295' sgcm 1005#

DST 5792-5807 open 2 hr. Rec. 710' gas

240' gcm 150' sw 1170# TD 5990

5" @ 5870 CO to TD 48/ 5619-31 1000 A

S/ 56 bo 12 hr. F/ 6 bo 12 hr. 3000 A

S/ 48 bo 12 hr. F/ 8 bo 12 hr.

S/ 15 boph 4 hr. P/ 50 to 60 bopd

Comp. 129 bopd

_____	Misc.
_____	Pierce Map
_____	France Map
_____	Tracings
_____	Land Wall Map
_____	Land Small Map
_____	Scout Cards

*mrm*

OCT 13 1964

# WILDCAT O.W.W.O.

FORM 513 SUNRAY

County	Meade	Elev.	
Sec.	32	Twp.	33
		Rgs.	30W
Company	Lion		
Farm Name	Ohio-Bond	No.	1

TOPS	DEPTH	LOG	DATUM	Loc. in Sec.
Anh.				NW NW SE
Tp. Atoka		5612		(OWWO)
H.				
Tr. Mor		5715		
Dg.				
Bl. Sand		5750		
L.				Geol.
K.C.				Contr.
B.K.C.				
Ce.				
C.				
M.		5784		Pool
M.				Wildcat
K.				<div style="border: 1px dashed black; padding: 5px; margin: 0 auto; width: 80%;">             JUL 31 57              0              FIRST REPORT           </div>
Mz.				
Mq.				
V.				
S.				
S.				
A.				
R.				
Pe.				
G.				
T.D. RTD		5990		

Date Comm. Columbian Fuel-FO  
5" @ 5870, State test PP/43.12 bo no wtr/8 hrs  
from perms 5619-31 PBD 5832

New Info-Spd. 7-25-57, RUCT Sq (5619-31)  
CO 5830, 16/5774-78 no show, B/10 gmwph,  
1000A, S/8.5 bwph, vss gas, frac 4 x/4, Swb  
4.5 bfph 90% wtr. very small amt gas W.O.O.

35

O.W.W.O.

23

County Meade Elev. \_\_\_\_\_  
 Sec. 32 Twp. 33 Rgs. 30W  
 Company Lion  
 FarmName Ohio-Bond No. 1

TOPS	DEPTH	LOG	DATUM
Anh.			
Tp. <u>Atoka</u>		<u>5612</u>	
H.			
Tr. <u>Mor</u>		<u>5715</u>	
Dg.			
Bl. <u>Sand</u>		<u>5750</u>	
L.			
K.C.			
B.K.C.			
Ce.			
C.			
M.		<u>5784</u>	
M.			
K.			
Mz.			
Mq.			
V.			
S.			
S.			
A.			
R.			
PE.			
G.			
TD. <u>RTD</u>		<u>5990</u>	

Loc. in Sec. NW NW SE

(O.W.W.O.)

Geol. \_\_\_\_\_

Contr. \_\_\_\_\_

Pool \_\_\_\_\_

Wildcat

ABANDONED

SEP 18 '57

Date Comm. Columbian Fuel-FO  
5" @ 5870, State test PP/43.12 bo no wtr/8 hrs.  
from perfs 5619-31 PBTB 5832  
New Info-Spd. 7-25-57, RUCT Sq (5619-31)  
CO 5830, 16/5774-78 no show, B/10 gmwph,  
1000A, S/8.5 bwph, vss gas, frac 4 x4, Swb  
4.5 bfph 90% wtr. very small amt gas W.O.O.  
AUG 8 '57 20/5810-15 PKR @ 5801 8 1/2  
BSwph no gas in 8 1/2 BSwph 2 hrs  
3500' Fluid in holes W.O.O. AUG 14 '57  
 AUG 21 '57 AUG 28 '57 SEP 4 '57 170A SEP 11 '57 SEP 18 '57