


Section 28 Township 18S Range 24W

Well No. #1 Leikam

Company Welch & Olsson

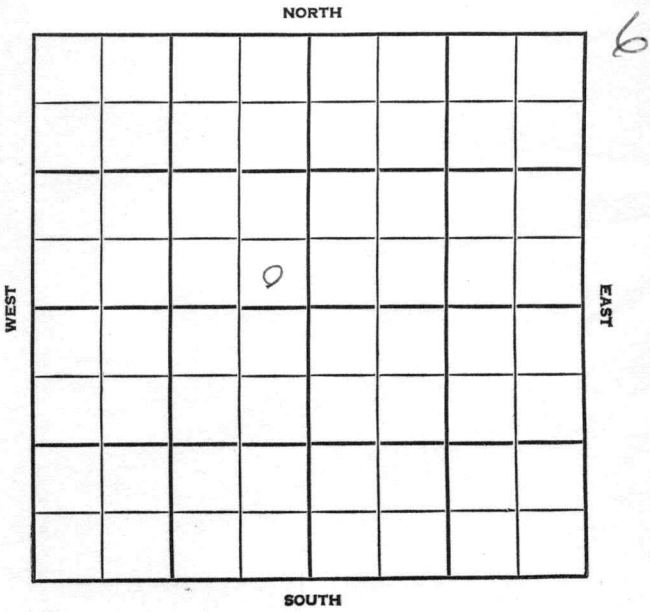

Ness

KANSAS

SEC. 28	TWP. 18S	R. 24W
------------	-------------	-----------

WELL NO. #1 Leikam

COMPANY Welch & Olsson

CONTRACTOR


WILDCAT

_____ FT. FROM N. LINE

_____ FT. FROM S. LINE

_____ FT. FROM E. LINE

_____ FT. FROM W. LINE

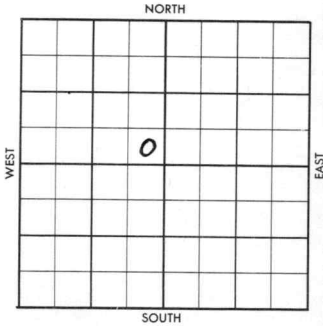

SE SE NW

SDX - DHM

1956	ELEVATION 2287'	REPORT
------	--------------------	--------

6-20 Comm. 6-18-56
8" @ 211 w/175
WOC

7-3 DST 4275-4310 op 30 min, rec. 80' mud,
BHP 390 ~~XX~~ /20".
D & A
Anh. 930', H. 3669', Tr. 3689',
L. 3712', BKG 4021', Ft. Sct. 4219'
Ce. Sh. 4289', Cherty Cg. 4296',
M. 4315',
TD 4330'.

7-11 TD to be corrected to 4375'.
ABANDONED

15

County Ness Elev. _____
 Sec. 28 Twp. 18S Rge. 24W
 Company Welch & Olsson
 Farm Name Leikam No. 1

TOPS	DEPTH	LOG	DATUM
Anh.			
Tp.			
H.			
Tr.			
Dg.			
Bl.			
L.			
K.C.			
B.K.C.			
Ce.			
C.			
M.			
M.			
K.			
Mz.			
Ma.			
V.			
S.			
S.			
A.			
R.			
Pe.			
G.			
T.D.			

Loc. in Sec. SE SE NW

Geol. _____
 Contr. _____

Pool W.C.



Date Comm. 6/18/56 Surr (DHM) JUN 20 1956
8" 211 w/175, WOC

Co.
Lsc.
No.
Sec.
T.
R.

County Ness Elev. 2287
 Sec. 28 Twp. 18S Rge. 21W
 Company Welch & Olsson
 Farm Name Leikam No. 1

TOPS	DEPTH	LOG	DATUM	Loc. in Sec.						
Anh.	930			SE SE NW						
TP.										
H.	3669									
Tr.	3689									
Dg.				Geol.						
Bl.										
L.	3712			Contr.						
K.C.										
R.K.C.	4021			Pool						
Co. Ft set	4219									
Co. ce sh	4289			W.C.						
M. cherty co	4296									
M.	4315			<table border="1"> <tr> <td colspan="2">ABANDONED</td> </tr> <tr> <td></td> <td>0</td> </tr> <tr> <td>JUL</td> <td>3 1956</td> </tr> </table>	ABANDONED			0	JUL	3 1956
ABANDONED										
	0									
JUL	3 1956									
K.										
Mz.										
Me.										
V.										
S.										
S.										
A.										
R.										
PE.										
G.										
TD.	4330									

Date Comm. 5/18/56 Sunr (DHM)
8" 211 w/175, WOC JUN 27 '56 3865.
JUL 3 '56

DST 4275-4310 30" rec 80' Md
BHP 390/20"

DEA

Co.
Lse.
No.
Sec.
T.
R.