


Map No. **KANSAS** Sec. 27 Twp. 27 R. 5<sup>E</sup>

Well No. 8 "B" Hutchinson Farm  
Empire O & K Company

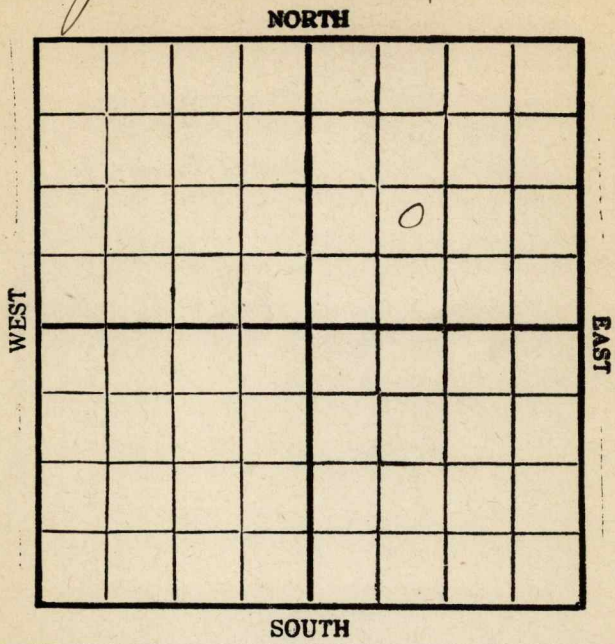

Location \_\_\_\_\_  
Drilling Remarks \_\_\_\_\_  
\_\_\_\_\_  
\_\_\_\_\_  
Rig Up \_\_\_\_\_  
Drilling Remarks \_\_\_\_\_  
\_\_\_\_\_  
\_\_\_\_\_  
**RECORD**

Cased \_\_\_\_\_ in. \_\_\_\_\_ ft.  
Sand \_\_\_\_\_  
Gas \_\_\_\_\_  
Oil \_\_\_\_\_  
Total Depth \_\_\_\_\_

**PRODUCTION**

1st 24 hrs. Nat. \_\_\_\_\_  
1st 24 hrs. after shot \_\_\_\_\_  
Gas \_\_\_\_\_ cu. ft. \_\_\_\_\_  
Dry Hole \_\_\_\_\_  
Abandoned \_\_\_\_\_

Map No. **KANSAS** Sec. 27 Twp. 27 R. 5<sup>E</sup>


Well No. 8-"B" Hutchinson Earth  
Empire O & R Company

\_\_\_\_\_ Ft. from N. Line

990 Ft. from S. Line

\_\_\_\_\_ Ft. from E. Line

990 Ft. from W. Line

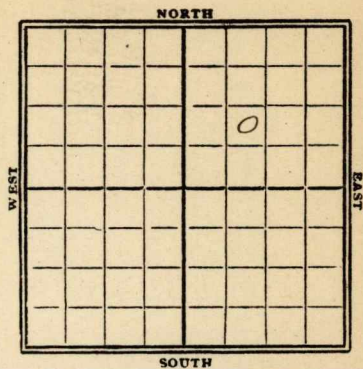

1929

Date	REPORT
7/17	Rd.
7/24	Rzldy Reg
7/31	Regnd up
8/17	Daly 640'
8/14	" 1445'
8/21	" 2180
8/28	" 2380
9/14	sand 2728-68'
	shot 70 gts
	swab 120 bbl 1 <sup>st</sup> 24 hr.
9/11	sand 2728-68'
	T.D. 2768'
	shot 70 qt
	120 bbl oil
	95 " water
	Pump.

Butler

Map No. **KANSAS** Sec. 27 Twp. 27 R. 5<sup>E</sup>

Well No. 8" B' Hutchinson

Empire O&R Company

Contractor

**FIRST REPORTS**

**SECTION PLAT**

\_\_\_\_\_ Ft. from N. Line

990 Ft. from S. Line

\_\_\_\_\_ Ft. from E. Line

990 Ft. from W. Line

		0	

Location \_\_\_\_\_

Rig up H.O.S.

Drilling and Remarks:

**RECORD**

Cased \_\_\_\_\_ in., \_\_\_\_\_ ft.

Sand \_\_\_\_\_

Gas \_\_\_\_\_

Oil \_\_\_\_\_

Total Depth \_\_\_\_\_

**PRODUCTION**

1st 24 hrs. Nat. \_\_\_\_\_

1st 24 hrs. after shot \_\_\_\_\_

Gas \_\_\_\_\_ Cu. Ft.

Dry Hole \_\_\_\_\_

Abandoned \_\_\_\_\_

Date

JUL 17 1929

**CHAS. L. SHERWOOD**

Butler

Map No. **KANSAS** Sec. 27 Twp. 27 R. 5

Well No. 8 B Hutchinson

Empire

Company

Contractor

**COMPLETE**

**SECTION PLAT**

\_\_\_\_\_ Ft. from N. Line

990 Ft. from S. Line

\_\_\_\_\_ Ft. from E. Line

990 Ft. from W. Line

		0	

Location \_\_\_\_\_

Rig up \_\_\_\_\_

Drilling and Remarks:

70/170 Bbs oil  
95" water

**RECORD**

Cased \_\_\_\_\_ in., \_\_\_\_\_ ft.

Sand 2728-2768

Gas \_\_\_\_\_

Oil \_\_\_\_\_

Total Depth 2768

**PRODUCTION**

1st 24 hrs. Nat. \_\_\_\_\_

1st 24 hrs. after shot \_\_\_\_\_

Gas \_\_\_\_\_ Cu. Ft.

Dry Hole \_\_\_\_\_

Abandoned \_\_\_\_\_

Date

SEP 11 1929

**CHAS. L. SHERWOOD**