

KANSAS


Ness County

FORM 51 5M PETROL

Section 5 Township 18 Range 25W

Well No. 2 Kuehn

Company Continental

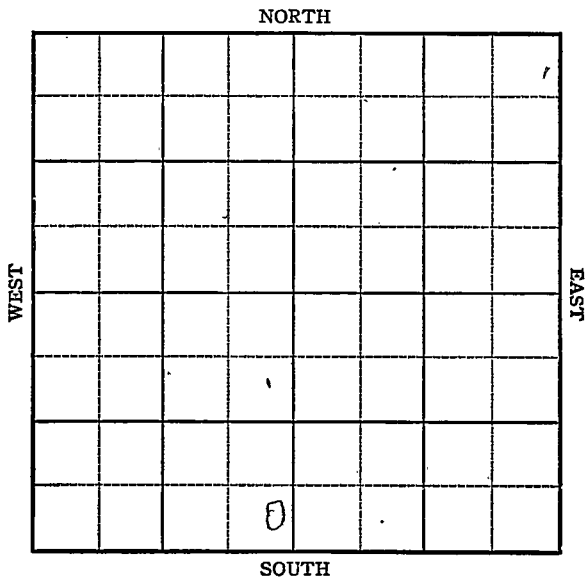

KANSAS

Ness

Sec. 5 Twp. 18 R. 25W

Well No. 2 Kuehn Farm

Continental Company

Aldrick

Ft. from N. Line

330

Ft. from S. Line


330

Ft. from E. Line

Ft. from W. Line

SE SW

Elev. 2440

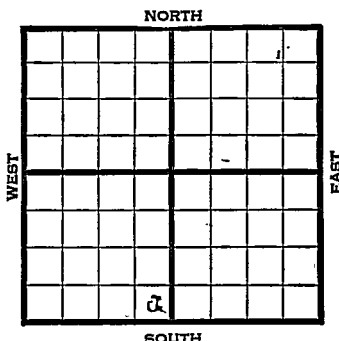

1945

REPORT

5/23	Location
5/31	"
6/8	Derrick
6/14	"
6/21	"
6/28	"
7/3	260 Run csg.
7/11	13" @ 245 8" @ 1475 Drlg. 2170'
7/19	Drlg. 2960
7/26	Drlg. 3920
8/1	Drlg. 4359
8/8	Lans 3778 Miss 4343 SO TD 4369 5" @ 4368 RUST
8/15	24 shots 4349-4359 $\frac{1}{2}$ BW Per hr. 6 hrs.
8/22	1000 acid. SO & W 75 shots 4343-4368 1500 acid
8/29	Drlg. 4405 SW
9/5	TD 4450 2 gals. oil plus 1-3/4 bbls. WPH
9/12	Miss. 4343 6" @ 4368 TD 4459'

ABANDONED

Kansas Pool Name Aldrich

Map No. 97 Sec. 5 Twp. 18 R. 25W

Well No. 2 Kuehn

Continental Company

FIRST REPORT

Contractor

SE SW

SECTION PLAT

_____ Ft. from N. Line

330 Ft. from S. Line

330 Ft. from E. Line

_____ Ft. from W. Line

Ness County

Location X

Rig up _____

Drilling and Remarks:

RECORD

Cased _____ in., _____ ft.

Sand _____

Gas _____

Oil _____

Total Depth _____

PRODUCTION

1st 24 hrs. Nat. _____

1st 24 hrs. after shot _____

Gas _____ Cu. Ft.

Dry Hole _____

Abandoned _____

Date

MAY 23 1915 19

S. J. LEWIS

Scout

KANSAS Kansas Pool Name Aldrich
 Map No. 77 Sec. 5 Twp. 18 R. 25W
 Well No. 2 Kuehn

Continent al Company _____

ABANDONED Contractor _____

SE SW

F1.2440
SECTION PLAT

_____ Ft. from N. Line

330 Ft. from S. Line

330 Ft. from E. Line

_____ Ft. from W. Line

Ness County

Location _____

Rig up _____

Drilling and Remarks:

Miss 4843
6" 04968

RECORD

Cased _____ in., _____ ft.

Sand _____

Gas _____

Oil _____

Total Depth 4459

PRODUCTION

1st 24 hrs. Nat. _____

1st 24 hrs. after shot _____

Gas _____ Cu. Ft.

Dry Hole _____

Abandoned _____

Date

SEP 12 1945

19

S. J. LEWIS Scout