


Section 6 Township 18 Range 25W

Well No. #1 Dinges "B"

Company Bay Petroleum

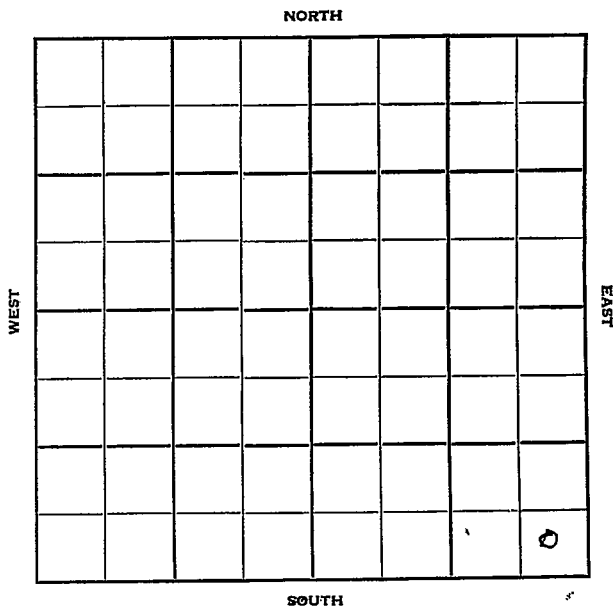

Sec. 6 Twp. 18 R. 25W

Well No. #1 Dinges "B" Farm

Bay Petroleum Company

Pickrell Drlg. - Contr. Contractor


_____ Ft. from N. Line

330' Ft. from S. Line

330' Ft. from E. Line

_____ Ft. from W. Line

SE SE SE

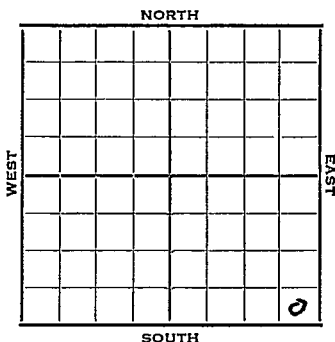

1952 Elev. 2447' REPORT

6/11 8" @ 279
Drlg. 800'

6/18 TD 4392 5" @ 4370'

6/25 D&A TD 4392' 8" @ 279
Heeb. 3714 Tor. 3736
Lans. 3758 Miss. 4365

DST 4368-77 open $\frac{1}{2}$ hr. rec. 4' mud

DST 4382-87 open $\frac{1}{2}$ hr. rec. 4' mud

DST 4382-87 open $\frac{1}{2}$ hr. rec. 8' mud

DST 4383-92 open 1 hr. rec. 9' mud

TD 4392 5" @ 4370 CO to 4392

500 A 3 bwph D&A

ABANDONED

