

Butler

Form 51-5M-9-28-27423

Map No. **KANSAS** Sec. 27 Twp. 27 R. 5

Well No. H- R. Sharrock Farm  
Empire Oil & R Company

NORTH

				0			

WEST

EAST

SOUTH

Location.....  
 Drilling Remarks.....  
 .....  
 .....  
Rig Up.....  
 Drilling Remarks.....  
 .....  
 .....  
RECORD

PRODUCTION

Cased..... in..... ft.  
 Sand.....  
 Gas.....  
 Oil.....  
 Total Depth.....

1st 24 hrs. Nat.....  
 1st 24 hrs. after shot.....  
 Gas..... cu. ft.....  
 Dry Hole.....  
 Abandoned.....

Map No. **KANSAS** Sec. 27 Twp. 27 R. 5

Well No. 4 - R. Sharrock Farm


Empire Oil & R. Company

330 Ft. from N. Line

..... Ft. from S. Line

..... Ft. from E. Line

330 Ft. from W. Line

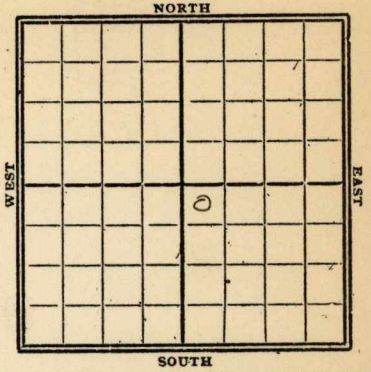

1928

Date

REPORT

11/14	Bldy Rig
11/21	Rig on top
11/28	10 rdg 375'
12/5	" 1115'
12/12	" 1840'
12/19	" 2320'
12/26	" 2320'

1929

1/2 sand 2714-39'  
 T.D. 2739'  
 shot 50 gts  
 60 bbls oil  
 Completed

Butler

K11 KANSAS

MAP NO. \_\_\_\_\_ SEC. 27 TWP. 27 R. 5

WELL NO. 4 B. Sharrow

Empire Oil Co

COMPANY

CONTRACTOR

FIRST REPORTS

SECTION PLAT

330 Ft. FROM N. LINE  
\_\_\_\_ Ft. FROM S. LINE  
\_\_\_\_ Ft. FROM E. LINE  
330 Ft. FROM W. LINE

		0	

LOCATION \_\_\_\_\_

RIG UP \_\_\_\_\_

DRILLING AND REMARKS:

Blog log

RECORD

CASED \_\_\_\_\_ IN. \_\_\_\_\_ FT.  
SAND \_\_\_\_\_  
GAS \_\_\_\_\_  
OIL \_\_\_\_\_  
TOTAL DEPTH \_\_\_\_\_

PRODUCTION

1ST 24 HRS. NAT. \_\_\_\_\_  
1ST 24 HRS. AFTER SHOT \_\_\_\_\_  
GAS \_\_\_\_\_ CU. FT.  
DRY HOLE \_\_\_\_\_  
ABANDONED \_\_\_\_\_

DATE

NOV 14 1928

CHAS. L. SHERWOOD

192

SCOUT

Butler

Map No. **K11** KANSAS Sec. **27** Twp. **27** R. **5**

Well No. **4 R. Sharroun**

**Empire** Company

Contractor

# COMPLETED

## SECTION PLAT

**330** Ft. from N. Line  
 ..... Ft. from S. Line  
 ..... Ft. from E. Line  
**330** Ft. from W. Line

		6	

Location.....

Rig up.....

Drilling and Remarks:

**50/60 Bl.**

### RECORD

Cased..... in., ..... ft.

Sand **2714-2739**

Gas.....

Oil.....

Total Depth **2739**

### PRODUCTION

1st 24 hrs. Nat.....

1st 24 hrs. after shot.....

Gas..... Cu. Ft.

Dry Hole.....

Abandoned.....

Date

JAN 2 1929

CHAS. L. SHERWOOD

192..... Scout