


Mess **KANSAS**

Section **7** Township **18** Range **25W**

Well Number **#1 Everett**

Company **Continental**

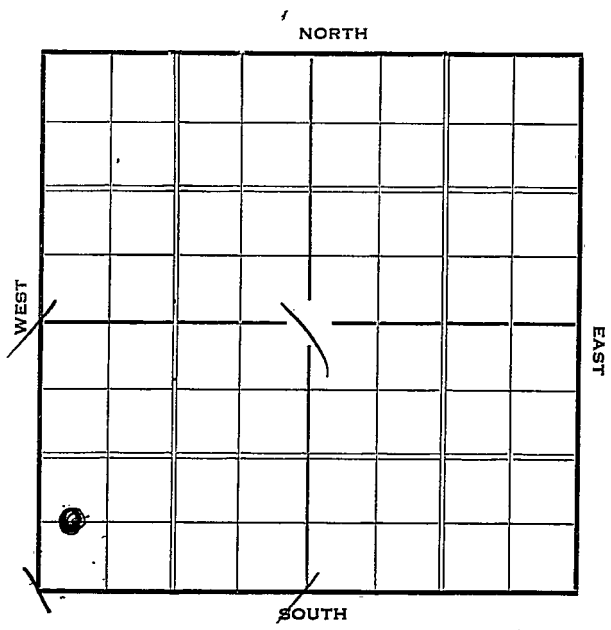

16" 214
 10" 1034
 6" 4673

Sec. 7 Twp. 18 R. 25W

Well No. #1 Everett Farm
Continental Company


 Ft. from N. Line

660' Ft. from S. Line

 Ft. from E. Line

330' Ft. from W. Line

Elev. 2506

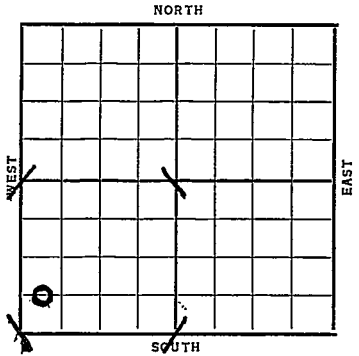

Date	REPORT
1937	
7/7	Location
7/16	"
7/23	R U R
7/30	"
8/6	16" @ 214'. Drlg. 707'.
8/13	10" @ 1034'. Drlg. 1500'.
8/20	Drlg. 2759'.
8/28	Drlg. 3375'.
9/3	Drlg. 4123'.
9/10	Cong. 4413': Dolomite 4437'.
	Cored 4437-69' T.D. no shows.
	Reaming.
9/17	Viola 4437' No shows.
	Cored 4437-4444'.
	T.D. 4625' Fsg.
9/24	Core 4716-21'. 1' oil.
	S.O. 4730-40'. Drlg. 4875'.
10/2	T.D. 4950'. Rng. 6".
10/8	" " " "

OVER

1937

10/15 T.D. 4950'. 6" @ 4673'.
Will make salt water disposal
well.

10/22 " " " "

10/29 " " " "

11/3 6" @ 4673'.
Viola 4437'.
T.D. 4950'.
7000 acid.
Salt water disposal well.
Input--750 B.W.P.H.

ABANDONED

Continental Geol. Dept. Tops

Top Lansing.....3855
Top Conglomerate..4413
Top Mississippi..4437
Top Siliceous....4810 ?

Wess **KANSAS**

Map No. 77 Sec. 7 Twp. 18 R. 25^W

Well No. 1 - Everett

Continental Company

Contractor

FIRST REPORT


SECTION PLAT

_____ Ft. from N. Line

660 Ft. from S. Line

_____ Ft. from E. Line

330 Ft. from W. Line

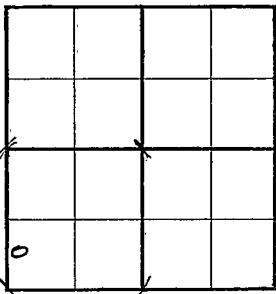

Location _____

Rig up _____

Drilling and Remarks:

RECORD

Cased _____ in., _____ ft.

Sand _____

Gas _____

Oil _____

Total Depth _____

PRODUCTION

1st 24 hrs. Nat. _____

1st 24 hrs. after shot _____

Gas _____ Cu. Ft.

Dry Hole _____

Abandoned _____

Date

JUL 7 1937

19

H. D. Hatfield

Scout

Map No. 77 Sec. 7 Twp. 18 R. 25W

Well No. 1 Everett

Continental Company

Contractor

COMPLETED

C W L SW SW

 Ft. from N. Line

660 Ft. from S. Line

 Ft. from E. Line

330 Ft. from W. Line

SECTION PLAT

0			

Location

Rig up

Drilling and Remarks:

7000 Acid.

SALT WATER.

Disposal Well.

INPUT - 750 BwP.H.

RECORD

Cased 6 in., 4673 ft.

Sand Viola 4437

Gas

Oil

Total Depth 4950

PRODUCTION

1st 24 hrs. Nat.

1st 24 hrs. after shot

Gas Cu. Ft.

Dry Hole

Abandoned

Date

NOV 3 193 19

H. D. Hatfield Scout