


Section 32 Township 17 Range 4-E

Well No. #1 Novak

Company Ring-Mac. Ward McGinnis et al

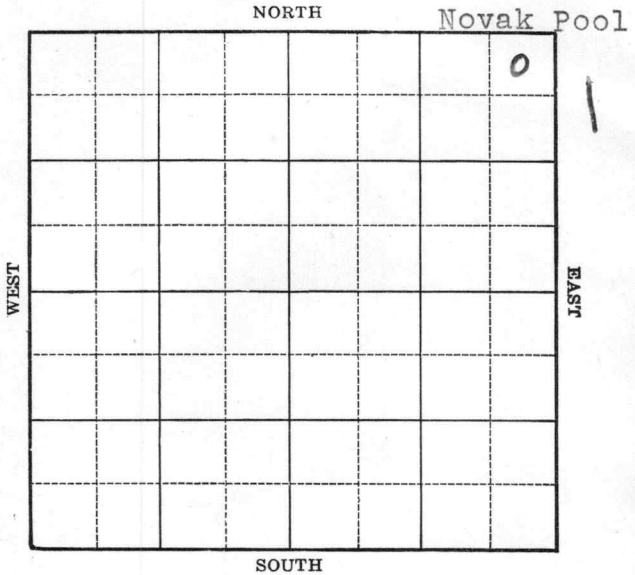

1941
3/19

Miss. 2396'
5" - 2408'
T.D. 2410'
Pump & flow 497 bbls., potential
36.7 Gravity

COMPLETED :

Map No. 26 Sec. 32 Twp. 17 R. 4EWell No. 1 NovakWard McGinnis etal CompanyFIRST REPORT Contractor

NE/C

330 Ft. from N. Line Ft. from S. Line330 Ft. from E. Line Ft. from W. Line

NOVAK POOL

SECTION PLAT

			8

Location XRig up

Drilling and Remarks:

RECORD

Cased in., ft.Sand Gas Oil Total Depth

PRODUCTION

1st 24 hrs. Nat. 1st 24 hrs. after shot Gas Cu. Ft.Dry Hole Abandoned

Date

DEC 11 1940

19

S. J. LEWIS Scout

Map No. 26 Sec. 32 Twp. 17 R. 4E

Well No. 12 Novak

Ring-Mac. Company

CORRECTION Contractor

SECTION PLAT

NE/C

330 Ft. from N. Line

_____ Ft. from S. Line

330 Ft. from E. Line

_____ Ft. from W. Line

			0

LOST SPRING POOL

Location _____

Rig up _____

Drilling and Remarks:

Was Ward McGinnis.

Changed name

RECORD

Cased _____ in., _____ ft.

Sand _____

Gas _____

Oil _____

Total Depth _____

PRODUCTION

1st 24 hrs. Nat. _____

1st 24 hrs. after shot _____

Gas _____ Cu. Ft.

Dry Hole _____

Abandoned _____

Date

JAN 29 1941

19

S. J. LEWIS

Scout

Map No. 26 Sec. 32 Twp. 17 R. 4E

Well No. 1 Novak

Ring-Mac Company

COMPLETED Contractor

SECTION PLAT

NE/C

330 Ft. from N. Line

_____ Ft. from S. Line

330 Ft. from E. Line

_____ Ft. from W. Line

NOVAK POOL

			2

Location _____

Rig up _____

Drilling and Remarks:

Miss 2896

5" C 2408

Pump & Flow 497 P.X

362 Gr.

RECORD

Cased _____ in., _____ ft.

Sand _____

Gas _____

Oil _____

Total Depth 2410

PRODUCTION

1st 24 hrs. Nat. _____

1st 24 hrs. after shot _____

Gas _____ Cu. Ft.

Dry Hole _____

Abandoned _____

Date

MAR 19 1941 19

S. J. LEWIS Scout