
Ness KANSAS

SECTION 5 TOWNSHIP 18 RANGE 25 W

WELL NO. #2 Fee

COMPANY R. P. Nixon & Cameron Reed

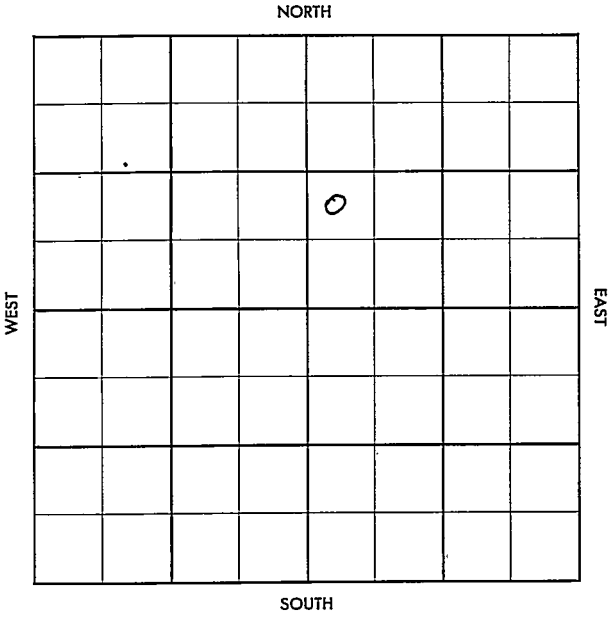

FORM 504-3 SUNRAY

Ness KANSAS

SEC.	TWP.	R.
5-	18	25W

WELL NO.

#2 Fee FARM

COMPANY

R.P. Nixon & Cameron Reed

CONTRACTOR

Mast Drlg.

Aldrich


_____ Ft. from N. Line

_____ Ft. from S. Line

_____ Ft. from E. Line

_____ Ft. from W. Line

NW SW NE

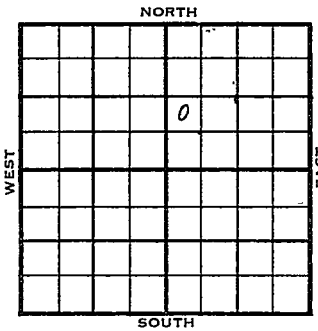

1955	ELEVATION 2381 REPORT
12-21	Comm. 12-19-55 8" @ 210, WOC
1956	
1-18	5½" @ 4290 DST 4290-97 op 1 hr. rec. 120' free oil 1050/20" CO to 4297 1 boph, 500 A S/ 18 bfph, 40% wtr. 4 hrs. Comp. 25 bopd, 10 bw H. 3638 L. 3684 Ft. Scott 4188 M. 4289 TD 4297' COMPLETED

DX-78

FORM 513 REV. SUNRAY

County Ness Elev.

Sec. 5 Twp. 18 Rge. 25W

Company R. P. Nixon & Cameron Reed

Farm Name Fee No. 2

TOPS	DEPTH	LOG	DATUM
Anh.			
Tp.			
H.			
Tr.			
Dg.			
Bl.			
L.			
K.C.			
B.K.C.			
Ce.			
C.			
M.			
M.			
K.			
Mz.			
Mo.			
V.			
S.			
S.			
A			
R.			
P€.			
G.			
T.D.			

Loc. in Sec. NW SW NE

Geol.

Contr. Mast Drlg.

Lse.

Pool Aldrich



Co.

No.

Sec.

T.

R.

Date Comm. 12-19-55

8" @ 210 WOC.

FORM 513 REV. SUNRAY

County Ness Elev. 2381

Sec. 5 Twp. 18 Rge. 25W

Company R. P. Nixon & Cameron Reed

Farm Name Fee No. 2


TOPS	DEPTH	LOG	DATUM
Anh.			
T.P.			
H.	3638		
Tr.			
Dg.			
Bl.			
L.	3684		1303
K.C.			
B.K.C.			
Ft Scott	4188		1807
C.			
M.	4289		1908
M.			
K.			
Mz.			
Mo.			
V.			
S.			
S.			
A			
R.			
P€.			
G.			
T.D.	4297		

Loc. in Sec. NW SW NE

Geol.

Contr. Mast Drlg.

Pool Aldrich

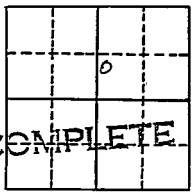

Date Comm. 12-19-55 JAN 18 1956

8" @ 210 5½" @ 4290 DST 4290-97

open 1 hr. rec. 120' free oil 1050/20"

Co to 4297 1 boph 500 A S/ 18 bfph

40% wtr. 4 hr. Comp. 25 bopd 10 bw

Co. Lse. No. Sec. T. R.