


KANSAS

Marion

Section 28 Township 17 Range 4-E

Well No. #1 Novak

Company Bashor etal

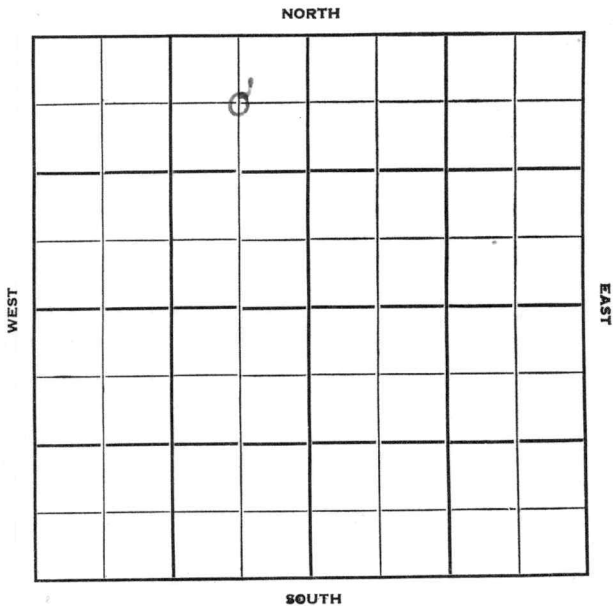

KANSAS

Marion

Sec. 28 Twp. 17 R. 4-E

Well No. #1 Novak Farm

Bashor et al Company

Mendenhall Drlg. Contractor

Lost Springs

660 Ft. from N. Line


\_\_\_\_\_ Ft. from S. Line

660 Ft. from E. Line

\_\_\_\_\_ Ft. from W. Line

C NE NW

(old wells abnd)

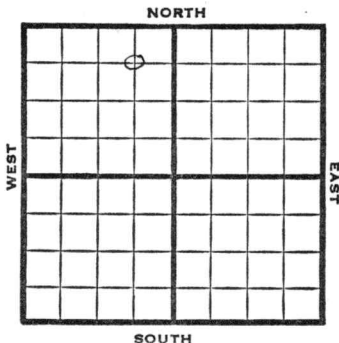

1950

Elev. - REPORT

11/8

Drlg

12/6

Oil Well TD 2438

8" @ 108'

Miss 2380-82 5" @ 2382

TD 2438 FU 45' oil 700' wtr 14 hr

Comp. 5 Bopd 80 bwpd

COMPLETED

County Marion State Kansas

Sec. 28 (Blk. 17) (Sur. Rge.) 4E Map No.

Operator Bashor etal.

Well No. 1 Farm Novak

Elev. Location C NE NW (old wells abd)

		⊕			

660 Ft. From N Line NW

660 Ft. From E Line Quarter

1st. Report NOV 8 1950

Completion

Remarks

Mendenhall Drlg. - Contr

Spudding Date

Drlg. Data Lost Springs Pool

drlg.

J. E. TYRA

