


Butler

Form 252A-5M-5-28-Mid-West

Map No. **KANSAS** Sec. 27 Twp. 27 R. 5

Well No. 5 - R. Sharrock Farm
Empire Oil & R. Company

330 Ft. from N. Line
..... Ft. from S. Line
330 Ft. from E. Line
..... Ft. from W. Line

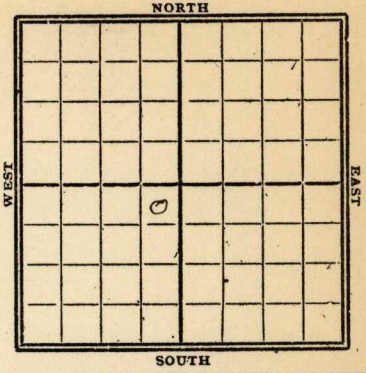

1928

Date	REPORT
11/14	Bldg Rig
11/21	Rig up
11/28	11 rly 550'
12/5	" 1360'
12/12	" 2110'
12/19	8" 2389'
12/26	set'g 6" - 2712'
1929	
1/2	sand 2726-53 T.D. 2753' shot 60 qts 367 bbls oil Completed

Butler

K I I KANSAS

MAP No. _____ SEC. 27 TWP. 27 R. 5

WELL No. 5 K. Sharrow

Empire Oil Co

COMPANY

CONTRACTOR

FIRST REPORTS

SECTION PLAT

330 FT. FROM N. LINE

FT. FROM S. LINE

330 FT. FROM E. LINE

FT. FROM W. LINE

	0		

LOCATION _____

Bloy Rig

RIG UP _____

DRILLING AND REMARKS:

RECORD

CASED _____ IN. _____ FT.

SAND _____

GAS _____

OIL _____

TOTAL DEPTH _____

PRODUCTION

1ST 24 HRS. NAT. _____

1ST 24 HRS. AFTER SHOT _____

GAS _____ CU. FT.

DRY HOLE _____

ABANDONED _____

DATE

NOV 14 1928

CHAS. L. SHERWOOD

192

SCOUT

KII KANSAS

Butler

Map No. _____ Sec. *27* Twp. *27* R. *5*

Well No. *65 R. Sharrock*

Empire

Company

Contractor

COMPLETED SECTION PLAT

330 Ft. from N. Line

_____ Ft. from S. Line

330 Ft. from E. Line

_____ Ft. from W. Line

	o		

Location _____

Rig up _____

Drilling and Remarks:

600/367 Abs.

RECORD

Cased _____ in., _____ ft.

Sand *2726-2753*

Gas _____

Oil _____

Total Depth *2753*

PRODUCTION

1st 24 hrs. Nat. _____

1st 24 hrs. after shot _____

Gas _____ Cu. Ft.

Dry Hole _____

Abandoned _____

Date

JAN 2 1929

192

CHAS. L. SHERWOOD

Scout