


Map No. KANSAS Sec. 15 Twp. 32 R. 4 ^E
Well No. 1 School Land Farm
270 Mab + Bart Company
J. A. HULL NORTH Co

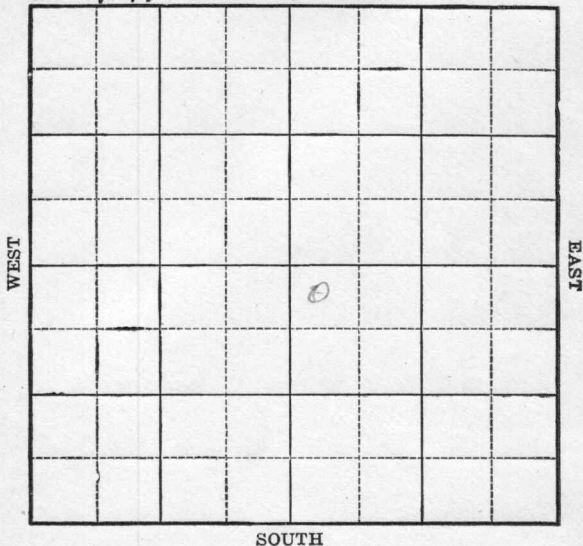

Location _____

Drilling Remarks:

Rig Up _____

Drilling Remarks:

RECORD

Cased _____ in. _____ ft.

Sand _____

Gas _____

Oil _____

Total Depth _____

PRODUCTION

1st 24 hrs. Nat. _____

1st 24 hrs. after shot _____

Gas _____ cu. ft.

Dry Hole _____

Abandoned _____

Map No. _____ Sec. 15 Twp. 32 R. 4Well No. 1 School Land Farm _____~~W. A. Hull & Co.~~ CompanyJ. A. Hull & Co.

NORTH


250 Ft. from N. Line

_____ Ft. from S. Line

_____ Ft. from E. Line

250 Ft. from W. Line

WEST

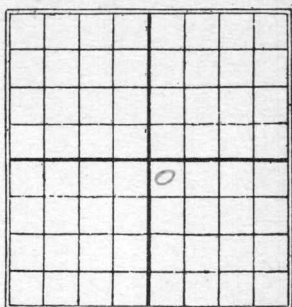

SOUTH

1926

Date

REPORT

1/8 Location1/4 _____1/30 _____1/27 _____2/4 _____2/10 _____2/17 _____2/24 _____3/5 _____3/10 _____3/18 _____3/25 _____4/1 _____4/7 Rig4/14 _____4/21 Spud.4/30 Drq 785.5/8 " 13955/12 " 1610'5/19 U.P. 10" 1755'6/2 Sho oil & Gas 2300-2384' sand
2605-16 3 1/4 m. gas & show oil
drq at 2700'

6/10 - S.P. 8" 2715
6/18 - top sand 2971-74
show oil & gas 1 m.
6/25 - top Wilcox 3304
show oil, running 6"

6-30 Top Silicious line 3304-3320
swabbed 660 BB 1st 24 hrs. 2
828 BB next 18 hrs. no water

7/9 - Sand 3304-3320
1075 bbls
40 Gravity

Cowley Co
 Map No. 3 **KANSAS** Sec. 15 Twp. 32 R. 4
 Well No. 1 *Schooh Land*
McC Mah & Bent Company

Contractor

FIRST REPORTS

SECTION PLAT

		o	

250 Ft. from N. Line

_____ Ft. from S. Line

_____ Ft. from E. Line

250 Ft. from W. LineLocation ✓

Rig up _____

Drilling and Remarks:

RECORD

Cased _____ in., _____ ft.

Sand _____

Gas _____

Oil _____

Total Depth _____

PRODUCTION

1st 24 hrs. Nat. _____

1st 24 hrs. after shot _____

Gas _____ Cu. Ft.

Dry Hole _____

Abandoned _____

Date

JAN 8 1926

192

CHAS. L. SHERWOOD

Scout

K2 KANSAS
 Map No. _____ Sec. *15* Twp. *32* R. *4*
 Well No. *1* *School land*
J. G. Hull & Co Company
 _____ Contractor

SECTION PLAT

250 Ft. from N. Line
 _____ Ft. from S. Line
 _____ Ft. from E. Line
250 Ft. from W. Line

		o	

CORRECTION

Location _____
 Rig up _____
 Drilling and Remarks:

Chg Ownership
to Choate

RECORD

Cased _____ in., _____ ft.
 Sand _____
 Gas _____
 Oil _____
 Total Depth _____

PRODUCTION

1st 24 hrs. Nat. _____
 1st 24 hrs. after shot _____
 Gas _____ Cu. Ft.
 Dry Hole _____
 Abandoned _____

Date

JUN 28 1926

CHAS. L. SHERWOOD

192

Scout

Cowley
 K2 KANSAS Sec. 15 Twp. 32 R. 4

Map No. _____
 Well No. 1 School Land
J. B. Hull & Co Company

Contractor

COMPLETED

SECTION PLAT

250 Ft. from N. Line

_____ Ft. from S. Line

_____ Ft. from E. Line

250 Ft. from W. Line

		10	

Location *Site line*

Rig up _____

Drilling and Remarks:

2605-16 3 1/4 in. Gas
 and show oil.

1075 lbs natural.
 40 Gravity.

RECORD

Cased _____ in., _____ ft.

Sand 3304-3320'

Gas _____

Oil _____

Total Depth 3320'

PRODUCTION

1st 24 hrs. Nat. _____

1st 24 hrs. after shot _____

Gas _____ Cu. Ft.

Dry Hole _____

Abandoned _____

Date

JUL 9 1926

CHAS. L. SHERWOOD

Scout