


Cowley

Map No. *TRANS* Sec. *15* Twp. *32* R. *4*

Well No. *1* *Wallace* Farm

J.A. Hull & Emerald Company

NORTH

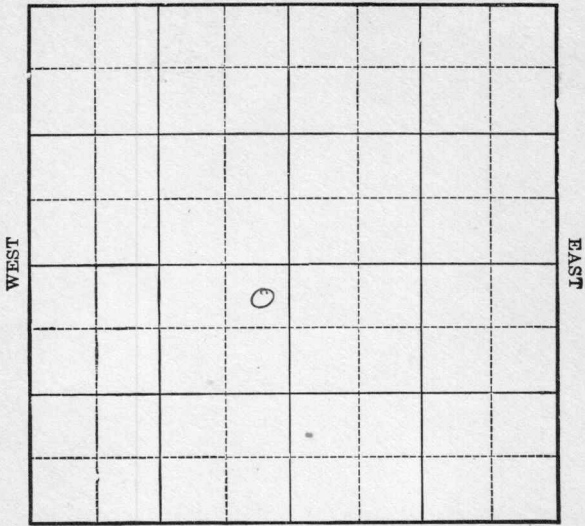

SOUTH

Location _____

Drilling Remarks

Rig Up _____

Drilling Remarks

RECORD

Cased _____ in. _____ ft.

Sand _____

Gas _____

Oil _____

Total Depth _____

PRODUCTION

1st 24 hrs. Nat. _____

1st 24 hrs. after shot _____

Gas _____ cu. ft.

Dry Hole _____

Abandoned _____

Cowley

Map No. Kansas Sec. 15 Twp. 32 R. 4


Well No. 1 Wallace Farm
J. A. Hull & Emerald Oil Company

320 Ft. from N. Line

..... Ft. from S. Line

330 Ft. from E. Line

..... Ft. from W. Line

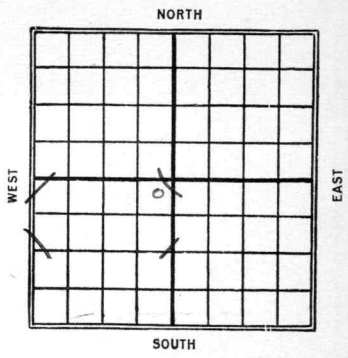

Date	REPORT
1926	
6/30	R.O.G.
7/8	Rigging up
7/15	Spudding
7/22	Drlg 975'
7/28	" 1525'
8/4	U.P. 10" 1695'
8/11	Drlg 2123'
8/18	Sand 2280-2375' show oil & gas, Drlg 2550'
8/25	3m gas 2540-50' Drlg 2600'
8/31	T.L. 2955'-Drlg
9/15	Silc line 3260-3287' sho oil & gas 2280-2375' 3m gas, 7 bbls water 366 bbls.

Rowley

K2 KANSAS Map No. _____ Sec. *15* Twp. *32* R. *4*

Well No. *1* *Hallac*
J. G. Hobb & Reynolds and Co. Company

Contractor

FIRST REPORTS

SECTION PLAT

330 _____ Ft. from N. Line
_____ Ft. from S. Line
330 _____ Ft. from E. Line
_____ Ft. from W. Line

<i>/</i>	<i>o</i>		
<i>/</i>		<i>/</i>	

Location _____
Rig up _____
Drilling and Remarks:

log

RECORD

Cased _____ in., _____ ft.
Sand _____
Gas _____
Oil _____
Total Depth _____

PRODUCTION

1st 24 hrs. Nat. _____
1st 24 hrs. after shot _____
Gas _____ Cu. Ft.
Dry Hole _____
Abandoned _____

Date
JUN 30 1926

CHAS. L. SHERWOOD

192 _____ Scout

Cowley

2, KANSAS Map No. Sec. 15 Twp. 32 R. 4

Well No. 1 Wallace

J. S. Hull & Emerald Co. Company

Contractor

COMPLETED

SECTION PLAT

330

----- Ft. from N. Line

----- Ft. from S. Line

330

----- Ft. from E. Line

----- Ft. from W. Line

Location *Dike line*

Rig up -----

Drilling and Remarks:

*show all logs 2280-2375
371 log 2540-50
top line 2955*

366 lbs oil

7 lbs water

RECORD

Cased ----- in., ----- ft.

Sand *3260-3287*

Gas -----

Oil -----

Total Depth *3287'*

PRODUCTION

1st 24 hrs. Nat. -----

1st 24 hrs. after shot. -----

Gas ----- Cu. Ft.

Dry Hole -----

Abandoned -----

Date SEP 15 1928

CHAS. L. SHERWOOD