


Butler

Form 51-5M-4-27-27423

Map No. **KANSAS** Sec. 27 Twp. 27 R. 5

Well No. 3 - Willits Farm
Empire Oil & R. Company

NORTH

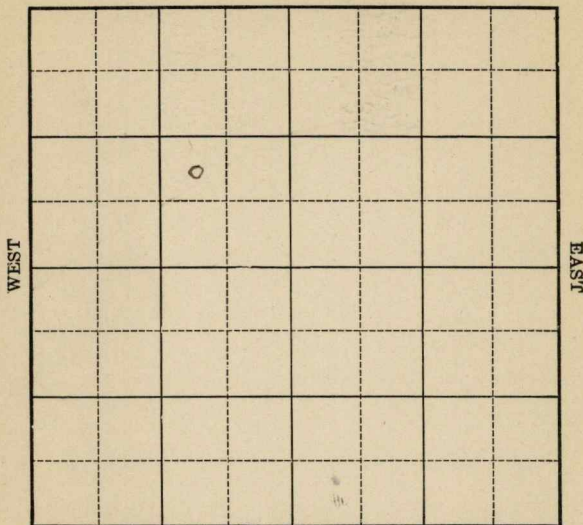

SOUTH

Location

Drilling Remarks

Rig Up

Drilling Remarks

RECORD

Cased in. ft.

Sand

Gas

Oil

Total Depth

PRODUCTION

1st 24 hrs. Nat.

1st 24 hrs. after shot


Gas cu. ft.

Dry Hole

Abandoned

Map No. KANSAS Sec. 27 Twp. 27 R. 5
 Well No. 3 - Millite Farm
Empire O & R. Co. Company

NORTH

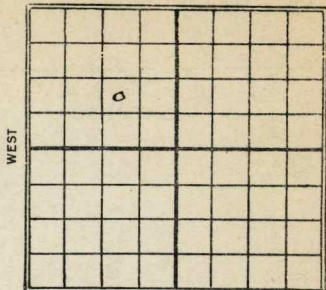

SOUTH

Ft. from N. Line

990 Ft. from S. Line

990 Ft. from E. Line

Ft. from W. Line

1928

Date

REPORT

9/2	Bldg Rig
9/9	Rig
9/26	Bldg 245'
10/3	Bldg 1054'
10/10	" 1825'
10/17	" 2324'
10/24	" 2695'
10/31	sand 2750-75'
	shot 140 gts - 7 bbls oil
	+ 22 bbls water 10 hrs.
11/7	sand 2750-75'
	swab 30 bbls water &
	no oil - Shut down
11/14	sand 2750-75'
	T'D 2775'
	shot 140 gts { 7 bbls oil
	22 " water
	dry & Abandoned

K11 KANSAS

MAP NO. _____ SEC. 27 TWP. 27 R. 5

WELL NO. 3 Willits

Empire Oil Co

COMPANY

CONTRACTOR

SECTION PLAT

FIRST REPORTS

_____ FT. FROM N. LINE

990 _____ FT. FROM S. LINE

990 _____ FT. FROM E. LINE

_____ FT. FROM W. LINE

	0		

RECORD

LOCATION _____

RIG UP _____

DRILLING AND REMARKS: _____

CASED _____ IN. _____ FT.

SAND _____

GAS _____

OIL _____

TOTAL DEPTH _____

PRODUCTION

1ST 24 HRS. NAT. _____

1ST 24 HRS. AFTER SHOT _____

GAS _____ CU. FT.

DRY HOLE _____

ABANDONED _____

DATE

SEP 12 1928

CHAS. L. SHERWOOD

192

SCOUT

K11 KANSAS

MAP NO. _____ SEC. 27 TWP. 27 R. 5WELL NO. 3 WillitsEmpire Oil Co COMPANY

CONTRACTOR

COMPLETED

SECTION PLAT

	o		

Ft. FROM N. LINE

990 Ft. FROM S. LINE990 Ft. FROM E. LINE

Ft. FROM W. LINE

ABANDONED

LOCATION _____

RIG UP _____

DRILLING AND REMARKS:

140 / 7 BS oil
22 " water.Dry & chd

RECORD

CASED _____ IN. _____ ET.

SAND 2750-2775

GAS _____

OIL _____

TOTAL DEPTH 2775

PRODUCTION

1ST 24 HRS. NAT. _____

1ST 24 HRS. AFTER SHOT _____

GAS _____ CU. FT.

DRY HOLE ☒ABANDONED ☒

DATE

NOV 14 1928

CHAS. L. SHERWOOD

192

SCOUT