


Section 15 Township 32 Range 4-E

Well No. #1 Youle

Company M. B. Armer

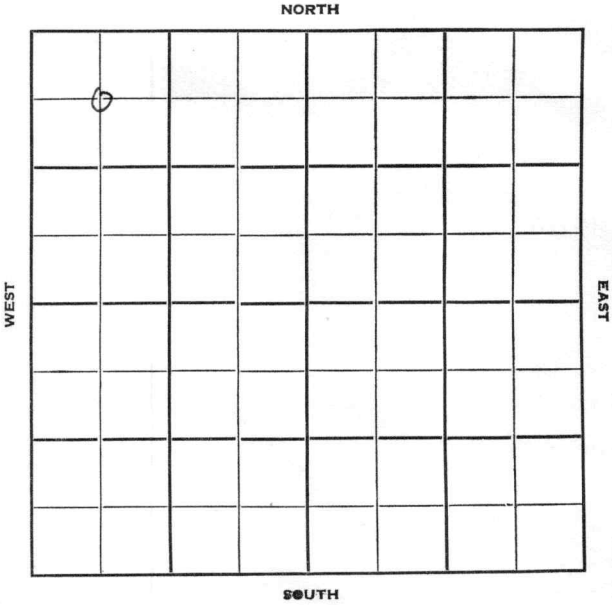

Cowley KANSAS

Sec. 15 Twp. 32 R. 4E ✓

Well No. #1 Youle Farm

M. B. Armer Company

Contractor


660' Ft. from N. Line

Ft. from S. Line

Ft. from E. Line

660' Ft. from W. Line

C NW NW

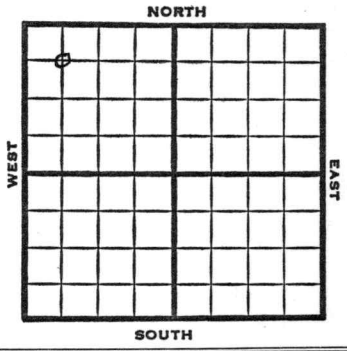

1951 Elev. 1137' REPORT

1/3 10" @ 83'  
Drlg. 435'

2/21 D&A TD 2333  
10" @ 83' Layton 2263  
7" @ 2305 TD 2333  
22/2162-69 15/2300-05  
12/2307-11 15/2313-18 1 goph  
D&A

**ABANDONED**


County Cowley State Kansas

Sec. 15 (Blk. 32 (Sur. 4E (Twp. 32 (Rge. 4E Map No.

Operator M. B. Armer

Well No. 1 Farm Youle

Elev. \_\_\_\_\_ Location C NW NW (old wells abd

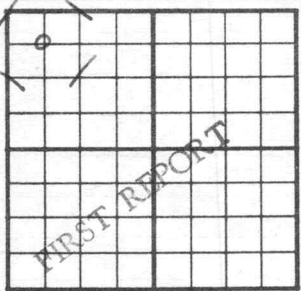

660 Ft. From N Line NW

660 Ft. From W Line Quarter

1st. Report JAN 3 1951

Completion \_\_\_\_\_

Remarks \_\_\_\_\_

Spudding Date \_\_\_\_\_

Drlg. Data \_\_\_\_\_

10" @ 83 drlg. 435


County Cowley State Kansas

Sec. 15 (Blk. 32) (Sur. 4E) (Twp.) (Rge.) Map No.

Operator M. B. Armer

Well No. 1 Farm Youle

Elev. 1137 Location C NW NW

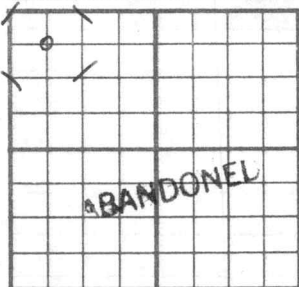

660 Ft. From N Line NW

660 Ft. From W Line Quarter

1st. Report \_\_\_\_\_

Completion FEB 21 1954

Remarks \_\_\_\_\_

Spudding Date \_\_\_\_\_

Drlg. Data D & A TD 2333

10" @ 83 Layton 2263 7" @ 2305 TD 2333

22/ 2162-69 15/ 2300-05 12/ 2307-11

15/ 2313-18 1 goph

D & A

J. E. TYRA