


Ness

Section 8 Township 18 Range 25W

Well No. #3 Aldrich

Company Continental

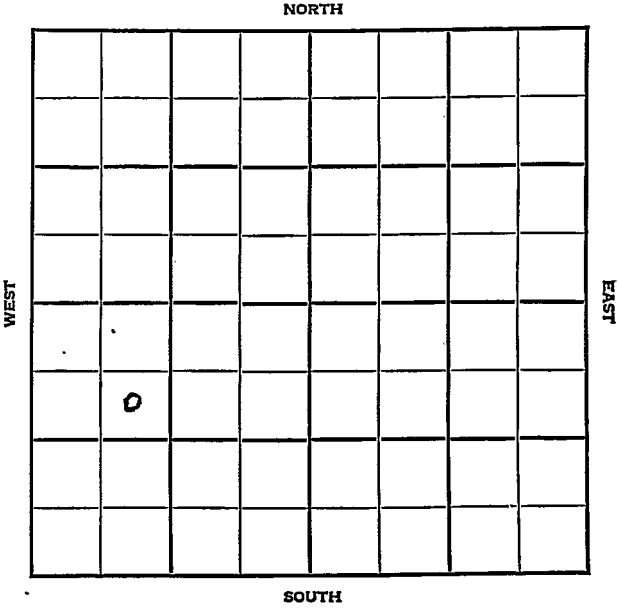

Sec. 8 KANSAS Twp. 18 R. 25W

Well No. #3 Aldrich Farm

Continental Company

Aldrich Pool


NORTH

990' Ft. from N. Line

_____ Ft. from S. Line

_____ Ft. from E. Line

990' Ft. from W. Line

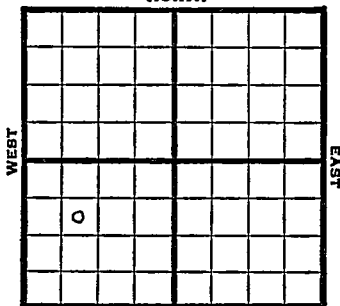

SOUTH

SE NW SW

1948 Eli 2474' REPORT

- 5/12 Location
- 5/19 RUR
- 5/26 13" @ 252'
WOC
- 6/1 9" @ 1516'
Drlg. 1870'
- 6/9 Drlg 3644'
- 6/16 Mississippi 4366'
TD 4371'
- 6/23 6" @ 4367'
Lansing 3796'
- 6/29 TD 4383'
1000 Acid
Swb 28 bbls oil PH 5 hrs.
- 7/8 " "
- 7/14 " "
- 7/21 " "
- 7/28 " "
- 8/4 Miss 4366'
6" @ 4367'
TD 4383'
1000 acid
Pump 370 oil Pot
375 Gr.
Comp

COMPLETED

Map No. _____ Sec. 8 Twp. 18 R. 25^W

Well No. 3 Aldrich

Continental Company

FIRST REPORT

Contractor

SE NW SW

SECTION PLAT

990 Ft. from N. Line

_____ Ft. from S. Line

_____ Ft. from E. Line

990 Ft. from W. Line

Ness County

Location X

Rig up _____

Drilling and Remarks:

RECORD

Cased _____ in., _____ ft.

Sand _____

Gas _____

Oil _____

Total Depth _____

PRODUCTION

1st 24 hrs. Nat. _____

1st 24 hrs. after shot _____

Gas _____ Cu. Ft.

Dry Hole _____

Abandoned _____

Date

MAY 12 1948 19

S. J. LEWIS Scout

Ness County Kansas State

Map No. 77 Sec. 8 Twp. 18 R. 25W

Well No. 3 Aldrich

Continental Company

COMPLETE Contractor

SE NW SW

E12474

SECTION PLAT

990 Ft. from N. Line

 Ft. from S. Line

 Ft. from E. Line

990 Ft. from W. Line

Aldrich Pool

Remarks:

*Mis 4366
6" @ 4367
YD 4383
1000 acid
Pump 370 oil 84
375 gr*

Date
AUG 4 1948

Scout **S. J. LEWIS**