


Section 8 Township 18 Range 25W

Well No. 1 Everett

Company C.U. Bay

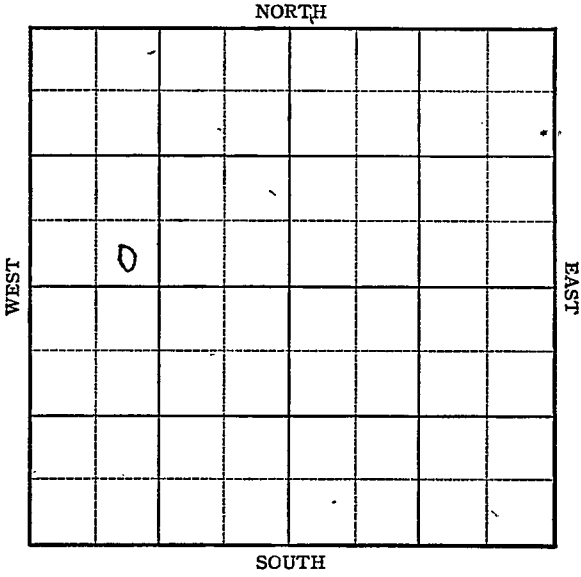

Sec. 8 Twp. 18 R. 25W

Well No. #1 Everett Farm

C.U. Bay Company

Aldrick


\_\_\_\_\_ Ft. from N. Line

330 Ft. from S. Line

\_\_\_\_\_ Ft. from E. Line

990 Ft. from W. Line

SE SW NW

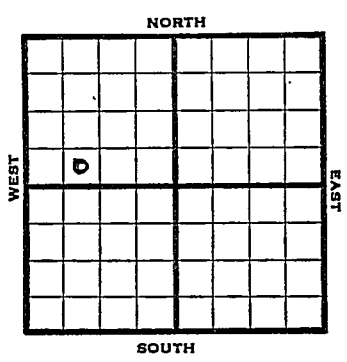

1946 Elev. 2475 REPORT

- 5/29 RUR
- 6/5 12" @ 236  
Drlg. 2725'
- 6/12 Blaine 930  
Anhy 1680  
Lans 3083'  
Drlg 4276'
- 6/18 Miss 4375  
TD 4395½  
Dropped 5" csg, Skid Rig  
5" east RUR
- 6/26 12" @ 236  
Drlg 3137'
- 7/3 Drlg 4071'
- 7/9 Anhy 1680  
Lans 3803  
Miss 4368  
TD 4369½-5" @ 4366½  
RUST
- 7/16 TD 4383-1000 acid  
Swb 5 oil PH 2 hrs
- 7/23 " " "
- 7/30 " " "
- 8/6 SD - - -

**COVER**

1946

8/14 Miss. 4368

5" @ 4366 $\frac{1}{2}$

1000 acid.

TD 4383

Pump 87 oil plus 10% Wtr. Pot.

Grav. 36.0

COMPLETED

**77** Kansas Pool Name Aldrick

**KANSAS**

Map No. \_\_\_\_\_ Sec. 8 Twp. 18 R. 25W

Well No. 1 Everett

C. U. Bay Company

**FIRST REPORT**

Contractor

SE SW NW

**SECTION PLAT**

\_\_\_\_\_ Ft. from N. Line

330 Ft. from S. Line

\_\_\_\_\_ Ft. from E. Line

990 Ft. from W. Line


Ness County

Location \_\_\_\_\_

Rig up \_\_\_\_\_

Drilling and Remarks:

RUR

**RECORD**

Cased \_\_\_\_\_ in., \_\_\_\_\_ ft.

Sand \_\_\_\_\_

Gas \_\_\_\_\_

Oil \_\_\_\_\_

Total Depth \_\_\_\_\_

**PRODUCTION**

1st 24 hrs. Nat. \_\_\_\_\_

1st 24 hrs. after shot \_\_\_\_\_

Gas \_\_\_\_\_ Cu. Ft.

Dry Hole \_\_\_\_\_

Abandoned \_\_\_\_\_

Date

MAY 29 1946

19

S. J. LEWIS

Scout

