

KANSAS


Cowley

Form 51-5M-3-26-22544

Map No. Kans. Sec. 15 Twp. 32 R. 4  
Well No. #1 State Land SWENSON Farm

Independ-McNabb. Company

NORTH

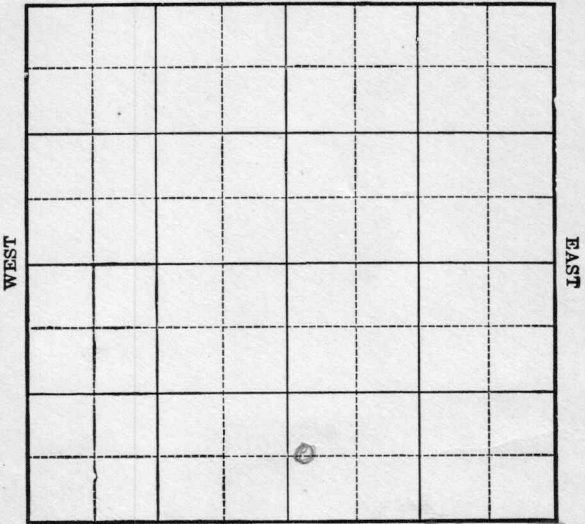

SOUTH

OWDD

Location \_\_\_\_\_  
Drilling Remarks \_\_\_\_\_

Rig Up \_\_\_\_\_  
Drilling Remarks \_\_\_\_\_

\_\_\_\_\_  
\_\_\_\_\_  
RECORD

PRODUCTION


Cased \_\_\_\_\_ in. \_\_\_\_\_ ft.  
Sand \_\_\_\_\_  
Gas \_\_\_\_\_  
Oil \_\_\_\_\_  
Total Depth \_\_\_\_\_

1st 24 hrs. Nat. \_\_\_\_\_  
1st 24 hrs. after shot \_\_\_\_\_  
Gas \_\_\_\_\_ cu. ft.  
Dry Hole \_\_\_\_\_  
Abandoned \_\_\_\_\_

Cowley

Map No. 15N Sec. 15 Twp. 32 R. 4  
 Well No. #1 State Land SW 1/4 SON Farm  
Independent & McVick Company

NORTH

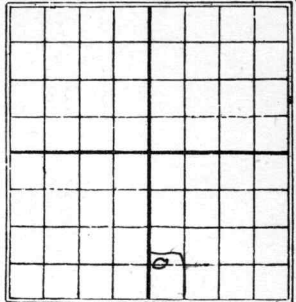

..... Ft. from N. Line  
660 Ft. from S. Line  
 ..... Ft. from E. Line  
140 Ft. from W. Line

1926

Date	REPORT
8/25	Rig up
8/31	
9/15	Drlg 510
9/22	" 1150
9/29	" 1620
10/13	" 2060
10/27	Sand 2306-2341
	20/130 bbls
1927	OWDP.
2/16	Drlg 2570'
2/24	Gas sands 2522-37
	" " 2604-11
	8 m gas from both sands.
	20.2611'
1928	OWDP
2/15	Top sand 2965-89
	Est. 1 1/2 m gas and spraying oil
4/23	
	(over)

3/1- 2965-2991 T.D. 2991

4 of 4 1/2 # gas  
spraying little oil

1929 OWDD

10/2- Old TD. 2611'

Reyn. up.

10/9- log. 3030'

10/16- set 5"- 3325'

10/23- Top Silc line 3337

TD. 3354' HFW

Dry & Abandon

Cowley

2 KANSAS

Map No. \_\_\_\_\_ Sec. 15 Twp. 32 R. 4

Well No. 1 State Land

Independent Oil & Gas Co. Company

Company

Contractor

FIRST REPORTS

SECTION PLAT

\_\_\_\_\_ Ft. from N. Line

660

\_\_\_\_\_ Ft. from S. Line

\_\_\_\_\_ Ft. from E. Line

140

\_\_\_\_\_ Ft. from W. Line

5 ac. Tract.

		07	

Location \_\_\_\_\_

Rig up

Drilling and Remarks:

RECORD

Cased \_\_\_\_\_ in., \_\_\_\_\_ ft.

Sand \_\_\_\_\_

Gas \_\_\_\_\_

Oil \_\_\_\_\_

Total Depth \_\_\_\_\_

PRODUCTION

1st 24 hrs. Nat. \_\_\_\_\_

1st 24 hrs. after shot \_\_\_\_\_

Gas \_\_\_\_\_ Cu. Ft.

Dry Hole \_\_\_\_\_

Abandoned \_\_\_\_\_

Date

AUG 25 1926

CHAS. L. SHERWOOD

192

Scout

Cowley

2 KANSAS Map No. Sec. 15 Twp. 32 R. 4

Well No. 1 State Land

Independent Oil & Gas Co. Company

Contractor

COMPLETED

SECTION PLAT

----- Ft. from N. Line

660 Ft. from S. Line

----- Ft. from E. Line

140 Ft. from W. Line


Location -----

Rig up -----

Drilling and Remarks:

209 130 BS.

RECORD

Cased \_\_\_\_\_ in., \_\_\_\_\_ ft.

Sand 2306 2341

Gas -----

Oil -----

Total Depth 2341'

PRODUCTION

1st 24 hrs. Nat. -----

1st 24 hrs. after shot -----

Gas ----- Cu. Ft.

Dry Hole -----

Abandoned -----

Date

OCT 27 1926

CHAS. L. SHERWOOD

192

Scout

2 KANSAS

Cowley

Map No. \_\_\_\_\_ Sec. 15 Typ. 32 R. 4

Well No. 1 State Land

Independent & Mc Nab Company

FIRST REPORTS

Contractor

O. W. D.

SECTION PLAT

\_\_\_\_\_ Ft. from N. Line

660 Ft. from S. Line

\_\_\_\_\_ Ft. from E. Line

140 Ft. from W. Line


Producing well only Deeper.

RECORD

Location \_\_\_\_\_

Cased \_\_\_\_\_ in., \_\_\_\_\_ ft.

Rig up \_\_\_\_\_

Sand \_\_\_\_\_

Drilling and Remarks:

Gas \_\_\_\_\_

5 AT 56 7522-37

Oil \_\_\_\_\_

Total Depth \_\_\_\_\_

Dely 7570

PRODUCTION

1st 24 hrs. Nat. \_\_\_\_\_

1st 24 hrs. after shot \_\_\_\_\_

Gas \_\_\_\_\_ Cu. Ft.

Dry Hole \_\_\_\_\_

Abandoned \_\_\_\_\_

Date FEB 16 1927

CHAS. L. SHERWOOD

*Cowley*

2 **KANSAS**  
Map No. \_\_\_\_\_ Sec. *15* Twp. *32* R. *4*

Well No. *1* *State Land*

*Independent of the State* Company

Contractor \_\_\_\_\_

**COMPLETED**

**SECTION PLAT**

\_\_\_\_\_ Ft. from N. Line

*660* Ft. from S. Line

\_\_\_\_\_ Ft. from E. Line

*140* Ft. from W. Line


*Oil well drilled deepport.*

Location \_\_\_\_\_

Rig up \_\_\_\_\_

Drilling and Remarks:

*Sub sands 2522-37*

*2604-11*

*8 M Cu-ft from*

*both sands*

**RECORD**

Cased \_\_\_\_\_ in., \_\_\_\_\_ ft.

Sand \_\_\_\_\_

Gas \_\_\_\_\_

Oil \_\_\_\_\_

Total Depth *2611'*

**PRODUCTION**

1st 24 hrs. Nat. \_\_\_\_\_

1st 24 hrs. after shot \_\_\_\_\_

Gas *8 M* Cu. Ft.

Dry Hole \_\_\_\_\_

Abandoned \_\_\_\_\_

Date

**FEB 24 1927**

**CHAS. L. SHERWOOD**

\_\_\_\_\_ 192 \_\_\_\_\_ Scout

*Cowley*

Map No. 2 KANSAS Sec. 15 Twp. 32 R. 4

Well No. 1 Swenson

Company Independent of McHabb

Contractor \_\_\_\_\_

FIRST REPORTS

SECTION PLAT

\_\_\_\_\_ Ft. from N. Line

660 Ft. from S. Line

\_\_\_\_\_ Ft. from E. Line

140 Ft. from W. Line


"old gas well o/g deeper."

Location \_\_\_\_\_

Rig up J.D. Was 2611

Drilling and Remarks:

Top sand 2965-89'  
Est 1 1/2 # gas and  
spraying oil.

RECORD

Cased \_\_\_\_\_ in., \_\_\_\_\_ ft.

Sand \_\_\_\_\_

Gas \_\_\_\_\_

Oil \_\_\_\_\_

Total Depth \_\_\_\_\_

PRODUCTION

1st 24 hrs. Nat. \_\_\_\_\_

1st 24 hrs. after shot \_\_\_\_\_

Gas \_\_\_\_\_ Cu. Ft.

Dry Hole \_\_\_\_\_

Abandoned \_\_\_\_\_

Date

FEB 15 1928

**CHAS. L. SHERWOOD**

192

Scout

2 KANSAS

Cowley

Map No. \_\_\_\_\_ Sec. 15 Twp. 32 R. 4

Well No. 1 Swenson

Indep & Mc Nabb

Company

Contractor

SECTION PLAT

COMPLETED

\_\_\_\_\_ Ft. from N. Line

660 Ft. from S. Line

\_\_\_\_\_ Ft. from E. Line

140 Ft. from W. Line


Location \_\_\_\_\_

Rig up \_\_\_\_\_

Drilling and Remarks:

40' 4 1/2" ~~4~~ Gas  
spraying bit at

RECORD

Cased \_\_\_\_\_ in., \_\_\_\_\_ ft.

Sand 2965-2991'

Gas \_\_\_\_\_

Oil \_\_\_\_\_

Total Depth 2991'

PRODUCTION

1st 24 hrs. Nat. \_\_\_\_\_

1st 24 hrs. after shot \_\_\_\_\_

Gas 4 1/2" ~~4~~ Cu. Ft.

Dry Hole \_\_\_\_\_

Abandoned \_\_\_\_\_

Date

MAR 1 1928

CHAS. L. SHERWOOD

192

Scout

*@awley*

Map No. KANSAS Sec. 15 Twp. 32 R. 4<sup>E</sup>

Well No. 1 Awenson

Independent & Mc Kabb Company

Contractor

**FIRST REPORTS**

         Ft. from N. Line

660 Ft. from S. Line

         Ft. from E. Line

140 Ft. from W. Line

*"old well deeper"*

**SECTION PLAT**


Location         

Rig up JD was 2611

Drilling and Remarks:

*Rigging up*

**RECORD**

Cased          in.,          ft.

Sand         

Gas         

Oil         

Total Depth         

**PRODUCTION**

1st 24 hrs. Nat.         

1st 24 hrs. after shot         

Gas          Cu. Ft.

Dry Hole         

Abandoned         

Date

OCT 2 1929

19

**CHAS. L. SHERWOOD**

Scout

*Cowley*

Map No. **KANSAS** Sec. *15* Twp. *32* R. *4*

Well No. *1* *Swenson*

*Independent & Mc Nab* Company

Contractor

**COMPLETE**

**SECTION PLAT**

.....Ft. from N. Line

*660* Ft. from S. Line

.....Ft. from E. Line

*140* Ft. from W. Line


**ABANDONED**

Location.....

Rig up.....

Drilling and Remarks:

*Top Oil lme 3337*

**RECORD**

Cased.....in., .....ft.

Sand.....

Gas.....

Oil.....

Total Depth *3354* *NFW.*

**PRODUCTION**

1st 24 hrs. Nat.....

1st 24 hrs. after shot.....

Gas.....Cu. Ft.

Dry Hole

Abandoned

Date

**OCT 23 1929**

**CHAS. L. SHERWOOD**

.....192.....Scout