


Butler

Form 51-5M-4-27-27423

Map No. **KANSAS** Sec. 27 Twp. 27 R. 5

Well No. 4 - Willits Farm
Empire O & R Company

NORTH

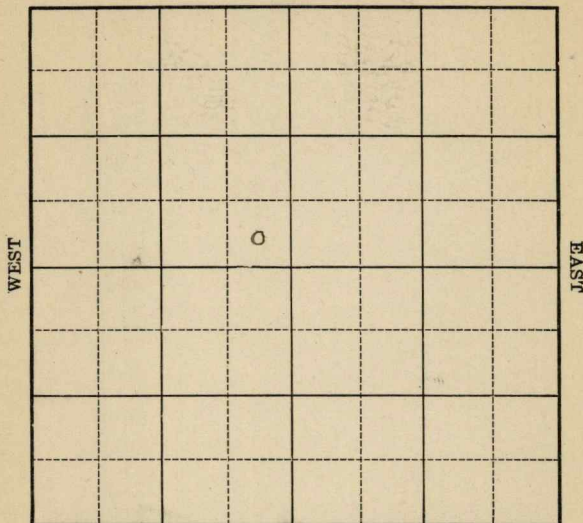

SOUTH

Location

Drilling Remarks

Rig Up

Drilling Remarks

RECORD

Cased in. ft.

Sand

Gas

Oil

Total Depth

PRODUCTION

1st 24 hrs. Nat.

1st 24 hrs. after shot


Gas cu. ft.

Dry Hole

Abandoned

Map No. KANSAS Sec. 27 Twp. 27 R. 5
 Well No. 4 - Hillits Farm
Empire O & R. Company

NORTH

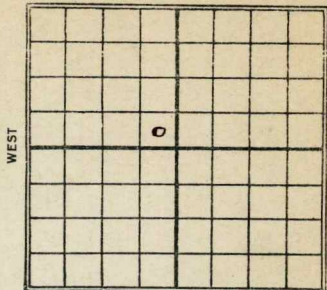

EAST

SOUTH

Ft. from N. Line

330 Ft. from S. Line

330 Ft. from E. Line

Ft. from W. Line

1928

Date

REPORT

9/12	Loc.
9/19	Bldg Rig
9/26	Spdg.
10/3	2 Orlg 750'
10/10	" 1725'
10/17	" 2315'
10/24	" 2515'
10/31	sand 2734'-57'
	shot 60 gts
	swabbed 20 bbl 12 hrs.
11/7	sand 2734 - 57'
	TD 2757'
	shot 60 yts
	200 bbls oil
	Comp.

K11 KANSAS

MAP NO. _____ SEC. 27 TWP. 27 R. 5WELL NO. 4 WillitsEmpire Oil Co COMPANY

CONTRACTOR

SECTION PLAT

FIRST REPORTS

_____ FT. FROM N. LINE

330 FT. FROM S. LINE330 FT. FROM E. LINE

_____ FT. FROM W. LINE

LOCATION ✓

RIG UP _____

DRILLING AND REMARKS: _____

RECORD

CASED _____ IN. _____ FT.

SAND _____

GAS _____

OIL _____

TOTAL DEPTH _____

PRODUCTION

1ST 24 HRS. NAT. _____

1ST 24 HRS. AFTER SHOT _____

GAS _____ CU. FT.

DRY HOLE _____

ABANDONED _____

DATE

SEP 12 1928

CHAS. L. SHERWOOD

192

SCOUT

K11 KANSAS

MAP NO. _____ SEC. 27 TWP. 27 R. 5

WELL NO. 4 Willits

Empire Oil Co

COMPANY

CONTRACTOR

SECTION PLAT

COMPLETED

_____ FT. FROM N. LINE

330 _____ FT. FROM S. LINE

330 _____ FT. FROM E. LINE

_____ FT. FROM W. LINE

	0		

LOCATION _____

RIG UP _____

DRILLING AND REMARKS:

60/200 Rb.

RECORD

CASED _____ IN. _____ FT.

SAND 2734-2757

GAS _____

OIL _____

TOTAL DEPTH 2757

PRODUCTION

1ST 24 HRS. NAT. _____

1ST 24 HRS. AFTER SHOT _____

GAS _____ CU. FT.

DRY HOLE _____

ABANDONED _____

DATE

NOV 7

1928

CHAS. L. SHERWOOD

192

SCOUT