

Butler

Form 51-5M-9-28-27423

Map No. **KANSAS** Sec. 27 Twp. 27 R. 5

Well No. ~~1~~ # 6 Willits Farm
Empire Oil & R. Company

NORTH

WEST

EAST

SOUTH

Location.....

Drilling Remarks

Rig Up.....

Drilling Remarks

RECORD

Cased.....in.....ft.

Sand.....

Gas.....

Oil.....

Total Depth.....

PRODUCTION

1st 24 hrs. Nat.....

1st 24 hrs. after shot.....

Gas.....cu. ft.....

Dry Hole.....

Abandoned.....


Butler
 Map No. **KANSAS** Sec. 27 Twp. 27 R. 5
 Well No. #6-Wellits Farm
 Empire Oil & R. Company

330 Ft. from N. Line

Ft. from S. Line

330 Ft. from E. Line

Ft. from W. Line

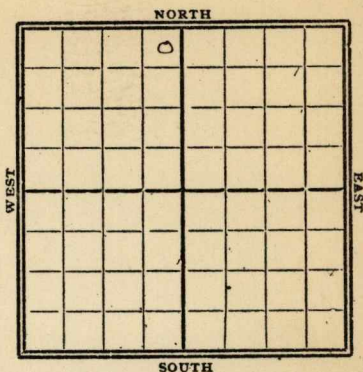

1928

Date

REPORT

11/21

Bldg Rig

11/28

Rig run up

12/12

1000' 590'

12/19

" 1165'

12/26

" 1990'

1929

1/2

" 2400'

1/9

sand 2729-72' - swab
 112 bbl oil & 7 bbl water
 1st 24 hrs. - Well shoot

1/16

sand 2729-72'
 T.D. 2772'

P.B. to 2765'

shot 80 gts

250 bbls oil
 Comp.

Butler

K11 KANSAS

MAP NO. _____ SEC. 27 TWP. 27 R. 5WELL NO. 7 WillitsEmpire Oil Co COMPANY

CONTRACTOR

FIRST REPORTS

SECTION PLAT

330 FT. FROM N. LINE

FT. FROM S. LINE

330 FT. FROM E. LINE

FT. FROM W. LINE

	0		

LOCATION _____

RECORD

RIG UP _____

DRILLING AND REMARKS: _____

CASED _____ IN. _____ FT.

SAND _____

GAS _____

OIL _____

TOTAL DEPTH _____

PRODUCTION

1ST 24 HRS. NAT. _____

1ST 24 HRS. AFTER SHOT _____

GAS _____ CU. FT.

DRY HOLE _____

ABANDONED _____

DATE

NOV 21 1928

CHAS. L. SHERWOOD

192

SCOUT

Butler

 111 KANSAS
 Map No. _____ Sec. 27 Twp. 27 R. 5

 Well No. 6
 Empire Oil Co. Company

Contractor

CORRECTION

SECTION PLAT

330 Ft. from N. Line

Ft. from S. Line

330 Ft. from E. Line

Ft. from W. Line

	0		

Location

Rig up

Drilling and Remarks:

 Prev reported
 as #7.
 chg to #6

RECORD

Cased _____ in., _____ ft.

Sand _____

Gas _____

Oil _____

Total Depth _____

PRODUCTION

1st 24 hrs. Nat. _____

1st 24 hrs. after shot _____

Gas _____ Cu. Ft.

Dry Hole _____

Abandoned _____

Date

DEC 12 1928

CHAS. L. SHERWOOD

192

Scout

Butter

 111 KANSAS SEC. 27 TWP. 27 R. 5
 WELL NO. 6 Willets

Empire Oil Co

COMPANY

CONTRACTOR

COMPLETE

330

FT. FROM N. LINE

FT. FROM S. LINE

330

FT. FROM E. LINE

FT. FROM W. LINE

SECTION PLAT

	0		

LOCATION

RIG UP

DRILLING AND REMARKS:

PB to 2765'

80/250 Bk.

RECORD

CASED IN. FT.

SAND 2729-2772

GAS

OIL

TOTAL DEPTH 2772

PRODUCTION

1ST 24 HRS. NAT.

1ST 24 HRS. AFTER SHOT

GAS Cu. Ft.

DRY HOLE

ABANDONED

DATE

JAN 16 1929

CHAS. L. SHERWOOD

192

SCOUT