

Cowley


KANSAS

SECTION 16 TOWNSHIP 32 RANGE 4E

WELL NO. #1 Conrad

COMPANY Susmio Oil

NORTH

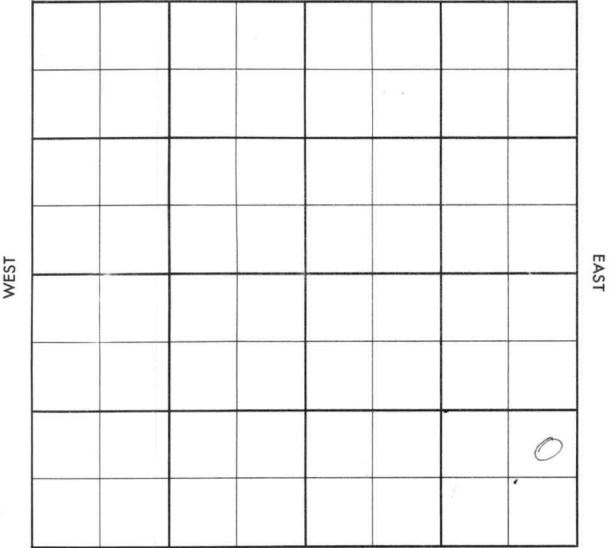

SOUTH

County Cowley Elev. \_\_\_\_\_  
 Sec. 16 Twp. 32 Rgs. 4E  
 Company Susnio Oil  
 Farm Name Conrad No. 1

TOPS	DEPTH	LOG	DATUM	Loc. in Sec.
Anh.				NE SE SE
Tp.				
H.				
Tr. <u>Stal.</u>	<u>1850</u>			
Dg.				
Bl. <u>Layton</u>	<u>2207</u>			
L.				Geol. _____
K.C.				Contr. _____
B.K.C.				<u>McKnab &amp;</u>
Ce.				<u>Lindsay</u>
C.				Pool _____
M.				<u>State Ext.</u>
M.				
K.				
Mz.				
Me.				
V.				
S.				
S.				
A.				
R.				
PE.				
G.				
T.D.				

FIRST REPORT  
 JAN 16 '57

Date Comm. 1-10-57  
8" @ 119/80 DST 2311-18 open 1/2 hr.  
rec. 5' mud 340/20" drlg. 2367

~~29~~

Co.  
Lse.  
No.  
Sec.  
T.  
R.

County Cowley Elev. 11,300  
 Sec. 16 Twp. 32 Rge. 4E  
 Company Susmie Oil  
 Farm Name Conrad No. 1

TOPS	DEPTH	LOG	DATUM	Loc. in Sec.
Anh.				NE SE SE
Tr.				
Dg.				
Bl. <u>Stal.</u>	<u>1850</u>	<u>1873</u>		
L. <u>Layton</u>	<u>2307</u>	<u>2305</u>		
K.C. <u>Cleveland</u>		<u>2587</u>		Geol.
B.K.C. <u>550290</u>		<u>2653</u>		Contr.
Ce. <u>Barth.</u>		<u>2921</u>		McKnab &
C.				Lindsay
M.		<u>2979</u>		Pool
M.				State Ext.
K.				
Mz.				
Me.				
V.				
S.				
S.				
A.				
R.				
Pe.				
G.				
T.D.	<u>2991</u>			

**COMPLETE**  
 FEB 27 '57

Date Comm. 1-10-57  
 8" @ 119/80 DST 2311-18 open  $\frac{1}{2}$  hr.  
 rec. 5' mid. 340/20" drls. 2367  
 JAN 23 '57 DST 2575-2600 1hr  
 270' gas rec 70' OCM BHP  
 435/120 DST 2601-10 open  
 1hr rec 75' OCM + 5' SW  
 BHP 665/20" DST 2925-43 1hr  
 180' gas rec 30' GCM BHP 120/20  
 DST 2943-55 1hr ~~490~~ 2890'

gas + 65' HO &amp; GCM 700/30"

DST 2955-65 1hr run

100' SW BHP 780/30 5 1/2

@ 2990/100 JAN 20 57 CO 2959

28/2939-46 @ 6 Gwph 3 hrs

1/2 FU Rate 14 G0 + 336

GW 8 hrs Frac 1 1/2 x 1

Flwd Ld + 13 BFph 8590 wth

9 hrs (new oil 94 hrs) Dock

5 @ FEB 6 57 Frac &amp; 3 B0 PIT

+ 4 Bwph 8 hrs Pop. FEB 13 57

FEB 20 57 FEB 27 57 P. 25 Bopd

8 Bwph.