

Map No. KANSAS Sec. 16 Twp. 32 R. 4^E


Well No. 3- Youle Farm
Indep. & Vickers Company

306 Ft. from N. Line

_____ Ft. from S. Line

687 Ft. from E. Line

_____ Ft. from W. Line

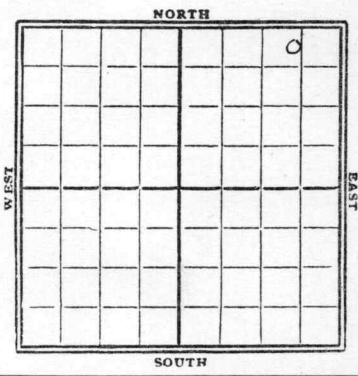

1929

Date REPORT

Date	REPORT
5/8	Location
5/15	Depth 265'
5/22	Depth 1190'
5/29	" 1600'
6/5	" 2065'
6/12	" 2300'
6/19	No report
6/26	Sile. line 3276-80' swabbing 25 bbls per hr. + 20% water
7/2	sand 3276-80' T.D. 3280' 250 bbls oil 125 " water 2000'

Map No. Sec. 16 Twp. 32 R. 4E

Well No. 3 you 12

Independent & Vickers Company
Contractor

SECTION PLAT

			0

306 Ft. from N. Line

..... Ft. from S. Line

687 Ft. from E. Line

..... Ft. from W. Line

FIRST REPORTS

Location

Rig up

Drilling and Remarks:

RECORD

Cased in., ft.

Sand

Gas

Oil

Total Depth

PRODUCTION

1st 24 hrs. Nat.

1st 24 hrs. after shot

Gas Cu. Ft.

Dry Hole

Abandoned

Date

MAY 8 1929 CHAS. L. SHERWOOD

Cowley

2 **KANSAS** Map No. Sec. 16 Twp. 32 R. 4

Well No. 3 Youle
Indep & Vickers Company
Contractor

SECTION PLAT

300 **COMPLETE** Ft. from N. Line
Ft. from S. Line
681 Ft. from E. Line
Ft. from W. Line

			0

Location _____
Rig up _____
Drilling and Remarks:
250 lbs oil.
175 lbs water.

RECORD

Cased _____ in., _____ ft.
Sand 3276-80
Gas _____
Oil _____
Total Depth 3280

PRODUCTION

1st 24 hrs. Nat. _____
1st 24 hrs. after shot _____
Gas _____ Cu. Ft.
Dry Hole _____
Abandoned _____

Date 7/2 1929

CHAS. L. SHERWOOD

Scout