


Map No. **KANSAS** Sec. 34 Twp. 27 R. 5^E
Well No. H-"A" Hutchinson Farm
Empire O & R Company

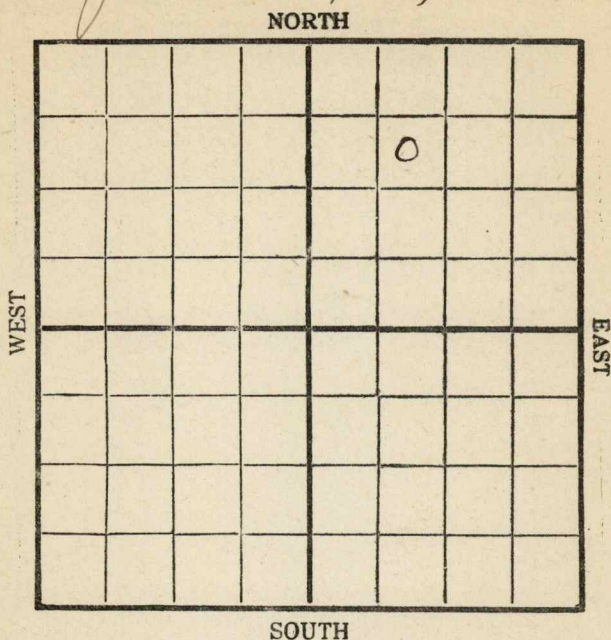

Location _____

Drilling Remarks _____

Rig Up _____

Drilling Remarks _____

RECORD

Cased _____ in. _____ ft.

Sand _____

Gas _____

Oil _____

Total Depth _____

PRODUCTION

1st 24 hrs. Nat. _____

1st 24 hrs. after shot _____

Gas _____ cu. ft. _____

Dry Hole _____

Abandoned _____

Butler

FORM 252A-5M-12-28-PETROL


Map No. **KANSAS** Sec. 34 Twp. 27 R. 5^E
Well No. 4-"H" Hutchinsons Farm
Empire O & K Company

990 Ft. from N. Line

_____ Ft. from S. Line

_____ Ft. from E. Line

990 Ft. from W. Line

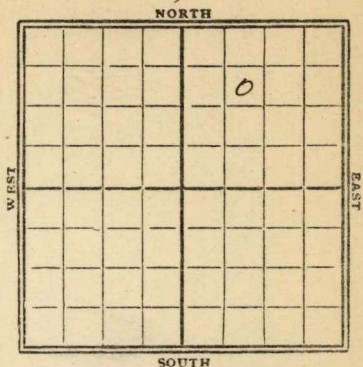

1929

Date	REPORT
8/1	Bldg Reg
8/17	Reg up
8/14	Dip log 145'
8/21	relg 920
8/28	" 1630
9/4	" 2345'
9/11	sand 2719-49'
	shot 80 qt
	2 bbl oil - some water
9/18	Top line 2758
	dry 2800'
9/25	dry 2921'
10/2	Top line 2758-3069
	Top Viola 3160'
	dry 3163' HFW
10/9	Top line 2758-3069
	Top Viola 3160'
	HFW at 3163
	T.D. 3172'
	(sand 2719-49')
	Dry & Abandoned

Butler

11 **KANSAS** E

Map No. 34 Sec. 27 Twp. 5 R. 5

Well No. 4 "a" Hutchinson

Empire Oil & Lgg Co Company

Contractor

SECTION PLAT.

FIRST REPORTS990 Ft. from N. Line

_____ Ft. from S. Line

_____ Ft. from E. Line

990 Ft. from W. Line

		0	

Location _____

Rig up Bldg Rig

Drilling and Remarks: _____

RECORD

Cased _____ in., _____ ft.

Sand _____

Gas _____

Oil _____

Total Depth _____

PRODUCTION

1st 24 hrs. Nat. _____

1st 24 hrs. after shot _____

Gas _____ Cu. Ft.

Dry Hole _____

Abandoned _____

Date

JUL 24 1929**CHAS. L. SHERWOOD**

charley we show a completed #3
well same Feet Measurements
As this ticket.

Check
THANKS
SAM

Sam

I mailed a Correction
on #3 this week, which will
fix this up ok. chas

Wall map
no small map

Returned	_____
Cards	_____
Tracing	_____
France Map	_____
Scarborough Map	_____
Moody Map	_____
Scarborough Plat Book	_____
Moody Plat Book	_____

CHAS L. SHERWOOD

JUL 2 1952

Butler

Map No. **KANSAS** Sec. 34 Twp. 27 R. 5Well No. 4 a Hutchinson

Empire

Dr

Company

Contractor

COMPLETE**SECTION PLAT**

		0	

990 Ft. from N. Line

_____ Ft. from S. Line

_____ Ft. from E. Line

990 Ft. from W. Line**ABANDONED**

Location _____

Rig up _____

Drilling and Remarks:

Top line 2758-3069'
 Top Viola 3160
 AKW 3163'

RECORD

Cased _____ in., _____ ft.

Sand 2719-49Gas 80/2 Bl show

Oil _____

Total Depth 2172**PRODUCTION**

1st 24 hrs. Nat. _____

1st 24 hrs. after shot _____

Gas _____ Cu. Ft.

Dry Hole ☒Abandoned ☒

Date

OCT 9 1929

CHAS. L. SHERWOOD

Scout