


Map No. **KANSAS** Sec. 22 Twp. 32 R. 4^E
Well No. 1 - Bertrand Farm
Geo. W. Hunkel Company

_____ Ft. from N. Line
105 Ft. from S. Line
_____ Ft. from E. Line
700 Ft. from W. Line

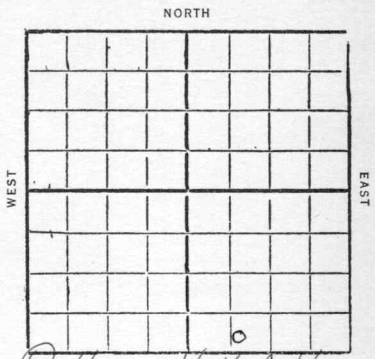

1932 lot 11-131k2 - College Hill Add.

Date	REPORT
<u>3/16</u>	<u>Cellar</u>
<u>3/22</u>	<u>Bldg rig</u>
<u>3/30</u>	<u>Rign up</u>
<u>4/6</u>	<u>Regd sep & SD</u>
<u>4/13</u>	<u>15" - 445</u>
	<u>12" - 1030</u>
	<u>Orlg 1145</u>
<u>4/20</u>	<u>" 1700'</u>
<u>4/27</u>	<u>10" - 1812</u>
	<u>TD 1967 Olg out</u>
<u>5/4</u>	<u>Card 2387 - 2439</u>
	<u>shaw gas at 2400</u>
	<u>" oil " 2410</u>
	<u>800' oil in hole</u>
	<u>TD 2439' 5 1/2" 8"</u>
<u>5/11</u>	<u>at TD 2439</u>
	<u>Est 100 bbls day</u>
	<u>Orlg 2655</u>
<u>5/18</u>	<u>TD 2665'</u>
	<u>P.B. to sand</u>
	<u>swab 131 bbl 12 hrs</u>
	<u>some water</u>

5/25 - Sand 2387-2439

TD. 2665

P.B. to 2410

Pump 210 bbl 1st 24 hr

" 190 " 2nd 24 "

(24 bbl water daily)

Comp.

Cawley

Map No. KANSAS Sec. 22 Twp. 32 R. 4 E

Well No. 1 *Burtrand*

Geo. W. Hinkel Company

Contractor

FIRST REPORTS

SECTION PLAT

_____ Ft. from N. Line

105 Ft. from S. Line

_____ Ft. from E. Line

700 Ft. from W. Line

hot 11 Blk 2.

College Hill addn

		0	

Location _____

Rig up *Cellar*

Drilling and Remarks:

RECORD

Cased _____ in., _____ ft.

Sand _____

Gas _____

Oil _____

Total Depth _____

PRODUCTION

1st 24 hrs. Nat. _____

1st 24 hrs. after shot _____

Gas _____ Cu. Ft.

Dry Hole _____

Abandoned _____

Date

MAR 16 1932

19

CHAS. L. SHERWOOD

Scout

Cowley

2 KANSAS

Map No. Sec. 22 Twp. 32 R. 4 E

Well No. 1 Burtrand

Geo W. Hinkel

Company

Contractor

COMPLETED

SECTION PLAT

Ft. from N. Line

105 Ft. from S. Line

Ft. from E. Line

700 Ft. from W. Line

Lot 11 Blk 2 College Hill add

Location

Rig up

Drilling and Remarks:

PB to 2410

Pump 210 lbs 1st 24 hrs.

" 190 " 2nd 24 hrs.

24 Blo water per day

RECORD

Cased in., ft.

Sand 7387-7439

Gas

Oil

Total Depth 7665

PRODUCTION

1st 24 hrs. Nat.

1st 24 hrs. after shot

Gas Cu. Ft.

Dry Hole

Abandoned

Date

MAY 25 1932

CHAS. L. SHERWOOD

192

Scout