


Map No. **KANSAS** Sec. 34 Twp. 27 R. 5^E
Well No. 3-"C" W Hutchinson Farm
Empire O & R Company
NORTH

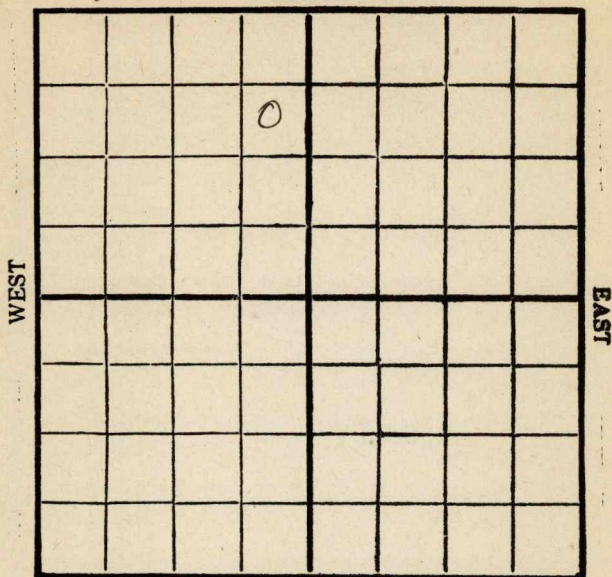

SOUTH

Location _____

Drilling Remarks _____

Rig Up _____

Drilling Remarks _____

RECORD

Cased _____ in. _____ ft.

Sand _____

Gas _____

Oil _____

Total Depth _____

PRODUCTION

1st 24 hrs. Nat. _____

1st 24 hrs. after shot _____


Gas _____ cu. ft. _____

Dry Hole _____

Abandoned _____

Butler
Map No. **KANSAS** Sec. 34 Twp. 27 R. 5^E
Well No. 3 "C" Hutchinsons Farm
Empire O & R Company

990 Ft. from N. Line
____ Ft. from S. Line
330 Ft. from E. Line
____ Ft. from W. Line

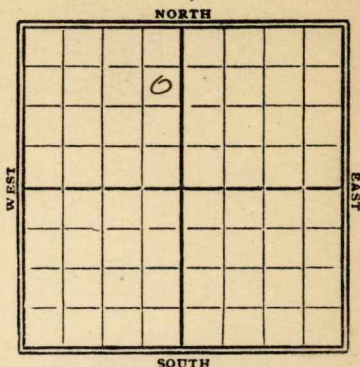

1929

Date

REPORT

7/24	Bldg Rig
7/31	to
8/17	Rig
8/14	Wagon up.
8/21	Rel 350
8/28	" 1080
9/4	" 1955'
9/11	" 2365'
9/18	sand 2726-55'
	T.D. 2755'
	shot 80 qt
	150 bbl oil
	Pump

Butler

Map No. **KANSAS** Sec. *34* Twp. *27* R. *5^E*

Well No. *3 "C" Hutchinson*

Empire OPR Co Company

Contractor

FIRST REPORTS*990* Ft. from N. Line

Ft. from S. Line

330 Ft. from E. Line

Ft. from W. Line

SECTION PLAT

	0		

Location

Rig up *Block Rig*

Drilling and Remarks:

RECORD

Cased _____ in., _____ ft.

Sand _____

Gas _____

Oil _____

Total Depth _____

PRODUCTION

1st 24 hrs. Nat. _____

1st 24 hrs. after shot _____

Gas _____ Cu. Ft.

Dry Hole _____

Abandoned _____

Date

JUL 24 1929

19

CHAS. L. SHERWOOD

Scout

KANSAS

Butler

Map No. _____ Sec. 34 Twp. 27 R. 5Well No. 3 C Hutchinson

Company _____

Contractor _____

COMPLETE**SECTION PLAT**

	0		

990 Ft. from N. Line

_____ Ft. from S. Line

330 Ft. from E. Line

_____ Ft. from W. Line

Location _____

Rig up _____

Drilling and Remarks:

80/150 BS.**RECORD**

Cased _____ in., _____ ft.

Sand 2726-2755

Gas _____

Oil _____

Total Depth 2755**PRODUCTION**

1st 24 hrs. Nat. _____

1st 24 hrs. after shot _____

Gas _____ Cu. Ft.

Dry Hole _____

Abandoned _____

Date

SEP 18 1929**CHAS. L. SHERWOOD**

192 _____

Scout