


Cowley

Form 51-5M-2-29-34703

Map No. **KANSAS** Sec. 22 Twp. 32 R. 4E

Well No. 1-1 Cavit Farm
Wakefield et al Company

NORTH

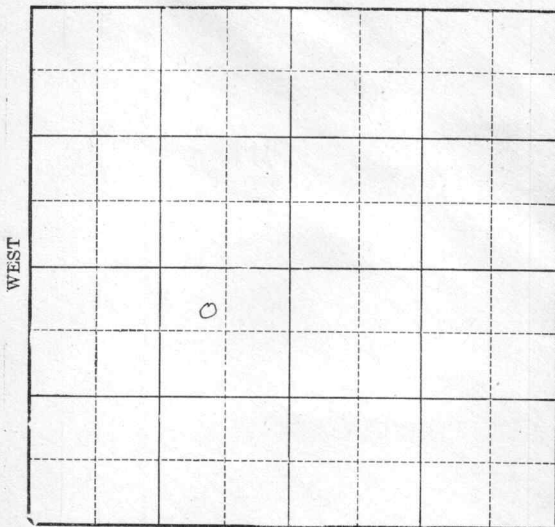

Lot 8-131k 31-Highland Park Add

Location _____

Drilling Remarks _____

Rig Up _____

Drilling Remarks _____

RECORD

Cased _____ in. _____ ft.

Sand _____

Gas _____

Oil _____

Total Depth _____

PRODUCTION

1st 24 hrs. Nat. _____

1st 24 hrs. after shot _____

Gas _____ cu. ft.

Dry Hole _____

Abandoned _____

Map No. KANSAS Sec. 22 Twp. 32 R. 4^E


Well No. 1- Cavit Farm
Wakefield et al Company

450 Ft. from N. Line

_____ Ft. from S. Line

840 Ft. from E. Line

_____ Ft. from W. Line

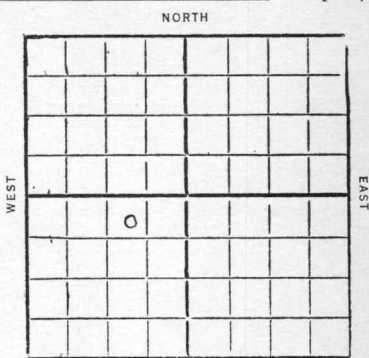

1932 Lot 8 - Blk 31 - Highland ^{SOUTH} Park Add

Date	REPORT
1/20	Bldg rig
1/27	Run up
2/3	15" - 390
2/10	Drlg 400
2/17	" 1225'
2/26	" 1678'
3/2	" 1850'
3/9	Setg 8" - 2020'
3/16	8" - 2127'
3/22	Show oil 2510-40
3/22	drlg 2540'
3/30	Setg 6" - 2895'
3/30	6" - 2895'
3/30	Card 2908
3/30	Show gas 2920-25
3/30	" Oil 2954-64
3/30	Top chat 2972
3/30	drlg 3065'
3/30	Silica line 3298-3310
3/30	ID. 3310
3/30	swab 250 bbl 24 hr
3/30	Comp.

Cowley

KANSAS

Map No. _____ Sec. *22* Twp. *32* R. *4* ^E

Well No. *1* _____

Waverfield Co al

Company

Contractor

FIRST REPORTS

450 Ft. from N. Line

_____ Ft. from S. Line

840 Ft. from E. Line

_____ Ft. from W. Line

lot 9 Blk 31

Highland Park Addn

SECTION PLAT

	<i>0</i>		

Location _____

Rig up _____

Drilling and Remarks:

Blag Rig

RECORD

Cased _____ in., _____ ft.

Sand _____

Gas _____

Oil _____

Total Depth _____

PRODUCTION

1st 24 hrs. Nat. _____

1st 24 hrs. after shot _____

Gas _____ Cu. Ft.

Dry Hole _____

Abandoned _____

Date

JAN 20 1932

192

CHAS. L. SHERWOOD

Scout

Cowley

2 **KANSAS** Map No. _____ Sec. *22* Twp. *32* R. *4* ^E

Well No. *1* *Cavit*

Wadejulo Co _____ Company

Contractor

COMPLETED

SECTION PLAT

450 Ft. from N. Line

_____ Ft. from S. Line

840 Ft. from E. Line

_____ Ft. from W. Line

	<i>0</i>		

Location _____

RECORD

Rig up _____

Cased _____ in., _____ ft.

Drilling and Remarks:

Sand *Siliceous 3298-3310*

Gas _____

awa 250 Bls

Oil _____

Total Depth *3310*

24 Hours.

PRODUCTION

1st 24 hrs. Nat. _____

1st 24 hrs. after shot _____

Gas _____ Cu. Ft.

Dry Hole _____

Abandoned _____

Date

MAR 30 1932

19

CHAS. L. SHERWOOD

Scout