


Cowley

KANSAS

SECTION 21 TOWNSHIP 32S RANGE 4E

WELL NO. #1 Giltner

COMPANY O.A. Sutton

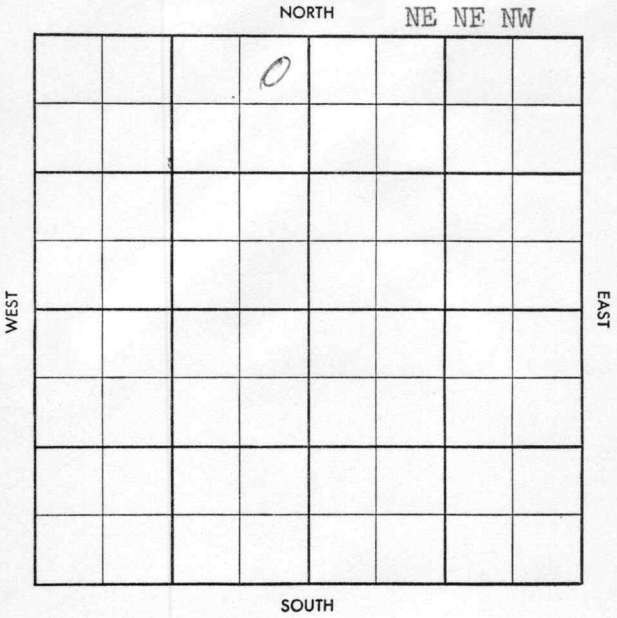

29

# WILDCAT

S-513-B

County Cowley Elev. \_\_\_\_\_  
 Sec. 21 Twp. 32 Rge. 4E  
 Company O. A. Sutton  
 Farm Name Giltner No. 1

TOPS	DEPTH	LOG	DATUM
Anh.			
Tp.			
H.			
Tr.			
Dg.			
B.L.			
L.			
K.C.			
B.K.C.			
Ce.			
C.			
M.			
M.			
K.			
Mz.			
Mq.			
V.			
S.			
S.			
A.			
R.			
Pf.			
G.			
T.D.			

Loc. in Sec. \_\_\_\_\_  
NE NE NW  
 Geol. \_\_\_\_\_  
 Contr. \_\_\_\_\_  
Renfro Drlg.  
 Pool \_\_\_\_\_  
Wildcat



Date Comm. \_\_\_\_\_  
RURT  
 \_\_\_\_\_  
 \_\_\_\_\_  
 \_\_\_\_\_  
 \_\_\_\_\_  
 \_\_\_\_\_  
 \_\_\_\_\_  
 \_\_\_\_\_

Co.  
Lse.  
No.  
Sec.  
T.  
R.

County Cowley Elev. \_\_\_\_\_  
 Sec. 21 Twp. 32 Rge. 4E  
 Company O. A. Sutton  
 Farm Name Giltner No. 1

TOPS	DEPTH	LOG	DATUM
Anh.			
Tp. <u>5x21</u>	<u>1860</u>		
H. <u>Log</u>	<u>2336</u>		
Tr.			
Dg.			
B.L.			
L.			
K.C.	<u>2482</u>		
B.K. <u>CO SW</u>	<u>2676</u>		
Ce. <u>Bart</u>	<u>2952</u>		
C.			
M.	<u>3014</u>		
M.			
K.			
Mz.			
Mq.			
V.			
S.			
S.			
A.			
R.			
Pf.			
G.			
T.D.	<u>3017</u>		

Loc. in Sec. NE NE NW  
 Geol. \_\_\_\_\_  
 Contr. Renfro Drlg.  
 Pool Wildcat  
 FEB 12 '58  
 ABANDONED

Date Comm. 2-4-58

RURT FEB 12 '58 197/125 DST 2950-95

120" 940' gip 80' M FP 30-55 BHP

475/20" DST 2985-95 25" 180'

gip 15' M 60' SW FP 30-55 BHP

8 90/30" no log

D6A