

Map No. **KANSAS** Sec. *34* Twp. *24* R. *3*
Well No. *2-A Hutchinson* Farm
Empire Oil & Gas Company

WEST

EAST

SOUTH

Location _____
Drilling Remarks _____

Rig Up _____ Drilling Remarks

RECORD

Cased _____ in. _____ ft.
 Sand _____
 Gas _____
 Oil _____
 Total Depth _____

PRODUCTION

1st 24 hrs. Nat. _____
 1st 24 hrs. after shot _____
 Gas _____ cu. ft. _____
 Dry Hole _____
 Abandoned _____


Butler
Map No. **KANSAS** Sec. 34 Twp. 27 R. 5
Well No. 2-A Hutchinson Farm
Empire O&R Company

330 Ft. from N. Line

_____ Ft. from S. Line

_____ Ft. from E. Line

330 Ft. from W. Line

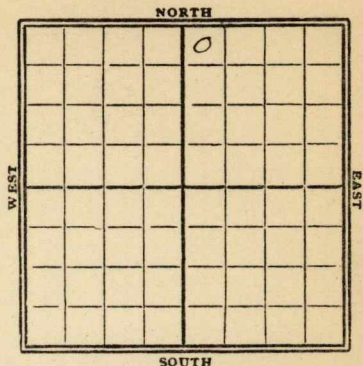

1929

Date	REPORT
3/13	R. I.
3/20	Bldg Rig
3/27	Spdg.
4/13	Drly 863'
4/10	" 1865'
4/17	" 2355'
4/24	sand 2702-29
	shot 80 gts - Pkg out
5/1	sand 2702-29
	T.D. 2729
	shot 80 gts
	220 bbls oil
	15 " water
	Pomp.

Butler

11 **KANSAS** Sec. 34 Twp. 27 R. 5

Map No. 2 "a" Hutchinson

Well No. Empire ODR Co. Company

Contractor

FIRST REPORTS

330 Ft. from N. Line

Ft. from S. Line

Ft. from E. Line

330 Ft. from W. Line

SECTION PLAT

		0	

Location *Ros*

Rig up

Drilling and Remarks:

RECORD

Cased.....in.,ft.

Sand.....

Gas.....

Oil.....

Total Depth.....

PRODUCTION

1st 24 hrs. Nat.....

1st 24 hrs. after shot.....

Gas.....Cu. Ft.

Dry Hole.....

Abandoned.....

Date

MAR 13 1929

192.....

CHAS. L. SHERWOOD

Scout

Map No. **KANSAS** Sec. *34* Twp. *27* R. *5*Well No. *2 a Hutchinson**Empire Oil Co* Company

Contractor

COMPLETE

SECTION PLAT

330 Ft. from N. Line

Ft. from S. Line

Ft. from E. Line

330 Ft. from W. Line

		0	

Location

Rig up

Drilling and Remarks:

80/220 B8 Oil
15 B8 Water

RECORD

Cased _____ in., _____ ft.

Sand *2702-2729*

Gas _____

Oil _____

Total Depth *2729*

PRODUCTION

1st 24 hrs. Nat. _____

1st 24 hrs. after shot _____

Gas _____ Cu. Ft.

Dry Hole _____

Abandoned _____

Date

MAY 1 1929

192

CHAS. L. SHERWOOD

Scout