

Map No. KANSAS Sec. 22 Twp. 32 R. 4^E

Well No. 1- Baker Farm

~~Jones et al~~ Company

S.A. MURPHY


150 Ft. from N. Line

_____ Ft. from S. Line

_____ Ft. from E. Line

1560 Ft. from W. Line

1932

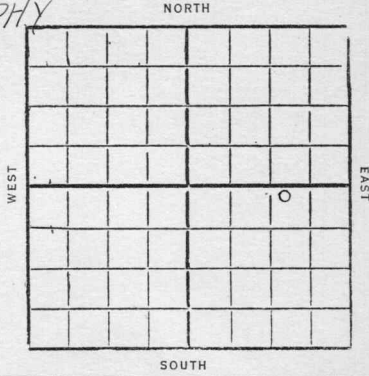

Date	REPORT
2/26	Loc
3/2	Moving in
3/9	Aug
3/16	Spdg
3/22	12"-470
	Dreg 685'
3/30	" 1410'
4/6	10"-1790
	HFW 1970-90
	Dreg 2035
4/13	8"-2210
	Sand 2400-18
	1200' oil in hole
	TD 2418
	Ang tubing
4/20	TD 2418' No test
4/27	Sand 2388-2410
	TD 2410
	shot 100 qt 2388-2410
	Cump 170 bbl oil
	Comp.

Cowley

2 KANSAS

Map No. _____ Sec. 22 Twp. 32 R. 4^E

Well No. 1 Baker

Jones C^y al

Company

Contractor

FIRST REPORTS

SECTION PLAT

150 Ft. from N. Line

_____ Ft. from S. Line

_____ Ft. from E. Line

1560 Ft. from W. Line

			o

Location

Rig up _____

Drilling and Remarks:

RECORD

Cased _____ in., _____ ft.

Sand _____

Gas _____

Oil _____

Total Depth _____

PRODUCTION

1st 24 hrs. Nat. _____

1st 24 hrs. after shot _____

Gas _____ Cu. Ft.

Dry Hole _____

Abandoned _____

Date

FEB 26 1932

19

CHAS. L. SHERWOOD

Scout

Cowley

2

KANSAS

Map No. _____ Sec. *22* Twp. *32* R. *H*

Well No. *1 Baker*

B. a. Murphy

Company _____

Contractor _____

CORRECTION

150 Ft. from N. Line

_____ Ft. from S. Line

_____ Ft. from E. Line

1560 Ft. from W. Line

SECTION PLAT

			o

Location _____

Rig up _____

Drilling and Remarks:

Chg Ownership

RECORD

Cased _____ in., _____ ft.

Sand _____

Gas _____

Oil _____

Total Depth _____

PRODUCTION

1st 24 hrs. Nat. _____

1st 24 hrs. after shot _____

Gas _____ Cu. Ft.

Dry Hole _____

Abandoned _____

Date

MAR 2 1932 CHAS. L. SHERWOOD

Cowley

E

2 KANSAS
Map No. Sec. *22* Twp. *32* R. *H*

Well No. *1* *Baker*

S. a. Murphy Company

Contractor

COMPLETED

150 Ft. from N. Line

..... Ft. from S. Line

..... Ft. from E. Line

1560 Ft. from W. Line

SECTION PLAT

			0

Location

Rig up

Drilling and Remarks:

Shot 100/2388-2410

Pump 170 Bls.

RECORD

Cased in., ft.

Sand *2388-2410*

Gas

Oil

Total Depth *2410*

PRODUCTION

1st 24 hrs. Nat.

1st 24 hrs. after shot

Gas Cu. Ft.

Dry Hole

Abandoned

Date

APR 27 1932

CHAS. L. SHERWOOD

192

Scout