

Cowley

Map No. KANSAS Sec. 22 Twp. 32 R. 4


Well No. 1 - City Lot Farm
Knock Drilling Co Company

380 Ft. from N. Line

_____ Ft. from S. Line

1170 Ft. from E. Line

_____ Ft. from W. Line

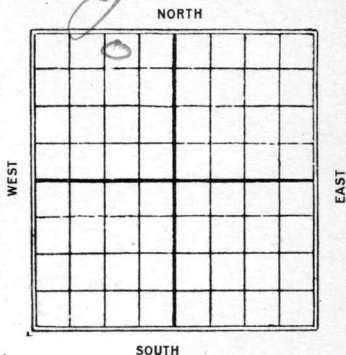

1927

Date REPORT

Date	REPORT
<u>11/30</u>	<u>Spudding</u>
<u>12/17</u>	<u>Drill 980'</u>
<u>12/14</u>	<u>" 1600'</u>
<u>12/21</u>	<u>" 1940</u>
<u>12/19</u>	<u>Top Sand 2375 - drill in -</u>
<u>1928</u>	
<u>1/6</u>	<u>2286-2350' TD. 2350</u> <u>20/15 bbl</u>
<u>1931</u>	<u>OWDD</u>
<u>11/18</u>	<u>Old TD. 2975</u> <u>Drill 3100'</u>
<u>11/24</u>	<u>Drill line 3311-18</u> <u>TD. 3318</u> <u>150 bbl</u> <u>show water</u> <u>Comp.</u>

2 KANSAS Map No. Sec. 22 Twp. 32 R. 4 E

Well No. 1 City Kat

Knox Drilling Co Company

Contractor

FIRST REPORTS

SECTION PLAT

380 Ft. from N. Line

Ft. from S. Line

1170 Ft. from E. Line

1170 Ft. from W. Line

Lot 7 Block 44

Musgrove addn, Winfield

Location

Rig up Spudding

Drilling and Remarks:

RECORD

Cased in., ft.

Sand

Gas

Oil

Total Depth

PRODUCTION

1st 24 hrs. Nat.

1st 24 hrs. after shot

Gas Cu. Ft.

Dry Hole

Abandoned

Date

NOV 30 1927

CHAS. L. SHERWOOD

MAP No. 2 KANSAS Sec. 22 Twp. 32 R. 4
Well No. 1 City Hot
Knox Drilling Co Company

Cowley

COMPLETED

380 Ft. from N. Line
Ft. from S. Line
1170 Ft. from E. Line
Ft. from W. Line

SECTION PLAT

	0		

Location -----
Rig up -----
Drilling and Remarks:
20718 Abs.

RECORD

Cased _____ in., _____ ft.
Sand 2286-2350
Gas -----
Oil -----
Total Depth 2350

PRODUCTION

1st 24 hrs. Nat. -----
1st 24 hrs. after shot -----
Gas ----- Cu. Ft.
Dry Hole -----
Abandoned -----

Date
JAN 6 1928

CHAS. L. SHERWOOD

Cowley
 Sec. *22* Twp. *32* R. *H* ^{*E*}

2 KANSAS
 Map No. Sec. Twp. R.

Well No. *1* *City Hat*

Knox Drilling Co

Company

Contractor

FIRST REPORTS

380 Ft. from N. Line

..... Ft. from S. Line

1170 Ft. from E. Line

..... Ft. from W. Line

LOT 7- Bk 44
Musgrove addn.

SECTION PLAT

	0		
	"	OWD	"

Location

Rig up

Drilling and Remarks:

Old JD 2975'

Blg 3100'

RECORD

Cased in., ft.

Sand

Gas

Oil

Total Depth

PRODUCTION

1st 24 hrs. Nat.

1st 24 hrs. after shot

Gas Cu. Ft.

Dry Hole

Abandoned

Date

NOV 13 1931

CHAS. L. SHERWOOD

192

Scout

Map No. 2 **KANSAS** Sec. 22 Twp. 32 R. 4^E

Well No. 1 City Gas
Know Drilling Co Company
Contractor

COMPLETED

SECTION PLAT

	0		
	OWN		

380 Ft. from N. Line

_____ Ft. from S. Line

1170 Ft. from E. Line

_____ Ft. from W. Line

hot 7 Blk 44
musgroves addn

Location _____

Rig up _____

Drilling and Remarks:

150 Bls
Shawg some water

RECORD

Cased _____ in., _____ ft.
Sand Seli Coors 331-18
Gas _____
Oil _____
Total Depth 3318

PRODUCTION

1st 24 hrs. Nat. _____
1st 24 hrs. after shot _____
Gas _____ Cu. Ft.
Dry Hole _____
Abandoned _____

Date
NOV 24 1931

CHAS. L. SHERWOOD
Scout