


*Cowley*

Map No. **KANSAS** Sec. *22* Twp. *32* R. *4E*

Well No. *L-1* *D. Cavit* Farm  
*North & Howard* Company

NORTH

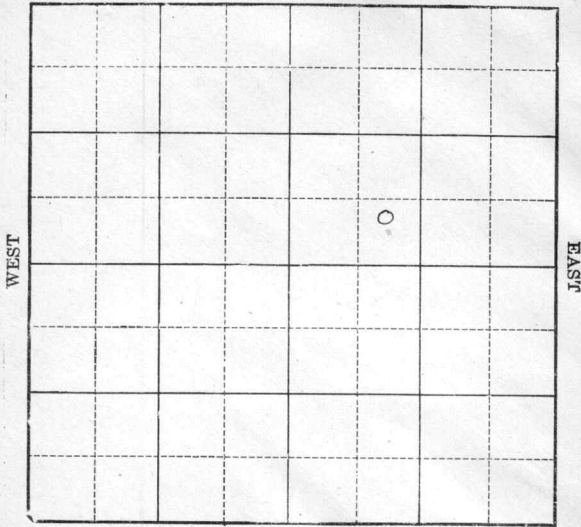

*C-31K 17- College View Add*

Location \_\_\_\_\_

Drilling Remarks \_\_\_\_\_

Rig Up \_\_\_\_\_

Drilling Remarks \_\_\_\_\_

**RECORD**

Cased \_\_\_\_\_ in. \_\_\_\_\_ ft.

Sand \_\_\_\_\_

Gas \_\_\_\_\_

Oil \_\_\_\_\_

Total Depth \_\_\_\_\_

**PRODUCTION**

1st 24 hrs. Nat. \_\_\_\_\_

1st 24 hrs. after shot \_\_\_\_\_

Gas \_\_\_\_\_ cu. ft.

Dry Hole \_\_\_\_\_

Abandoned \_\_\_\_\_


Cowley

Map No. KANSAS Sec. 22 Twp. 32 R. 4<sup>E</sup>

Well No. 1-D. Cavit Farm

Roth & Stewart Company

NORTH

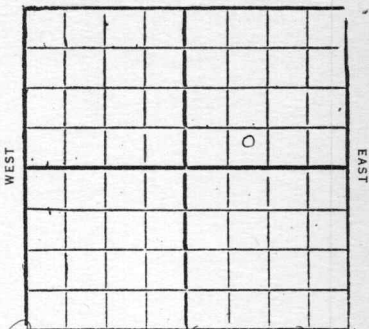

\_\_\_\_\_ Ft. from N. Line

510 Ft. from S. Line

\_\_\_\_\_ Ft. from E. Line

930 Ft. from W. Line

19.32 C-Blk 17 - College View Add

Date REPORT

2/3

Loc

2/10

2/17

Pond

2/26

3/2

3/2

3/9

3/16

3/22

3/30

4/6

4/13

4/20

4/27

5/4

5/11

5/18

Abandon location

*Cowles*

*2* KANSAS

Map No. \_\_\_\_\_ Sec. *22* Twp. *32* R. *4* <sup>E</sup>

Well No. \_\_\_\_\_

*Roth & Jurot*

Company

Contractor

FIRST REPORTS

SECTION PLAT

\_\_\_\_\_ Ft. from N. Line

*510* Ft. from S. Line

\_\_\_\_\_ Ft. from E. Line

*930* Ft. from W. Line

		o	

*@ Blk 17, College View Addn*

Location

Rig up \_\_\_\_\_

Drilling and Remarks:

RECORD

Cased \_\_\_\_\_ in., \_\_\_\_\_ ft.

Sand \_\_\_\_\_

Gas \_\_\_\_\_

Oil \_\_\_\_\_

Total Depth \_\_\_\_\_

PRODUCTION

1st 24 hrs. Nat. \_\_\_\_\_

1st 24 hrs. after shot \_\_\_\_\_

Gas \_\_\_\_\_ Cu. Ft.

Dry Hole \_\_\_\_\_

Abandoned \_\_\_\_\_

Date  
FEB 3 1932

CHAS. L. SHERWOOD

19

Scout

*Cowley*

*2* KANSAS

Map No. .... Sec. *22* Twp. *32* R. *4* E

Well No. *1* *D. Cavit*

*Roeth & Janney* Company

Contractor

COMPLETED

SECTION PLAT.

..... Ft. from N. Line

*510* Ft. from S. Line

..... Ft. from E. Line

*930* Ft. from W. Line

		o	

ABANDONED

Location.....

Rig up.....

Drilling and Remarks:

RECORD

Cased..... in., ..... ft.

Sand.....

Gas.....

Oil.....

Total Depth.....

PRODUCTION

1st 24 hrs. Nat.....

1st 24 hrs. after shot.....

Gas..... Cu. Ft.

Dry Hole.....

Abandoned *Location*

Date

MAY 1 3 1932 CHAS. L. SHERWOOD

192..... Scout