

KANSAS

Butler

Sec. 34 Twp. 27 R. 5E

Well No. #1 Kreeger Farm
H. & M. Drlg. Company

Miscellaneous


_____ Ft. from N. Line

330' Ft. from S. Line

330' Ft. from E. Line

_____ Ft. from W. Line

SE NE

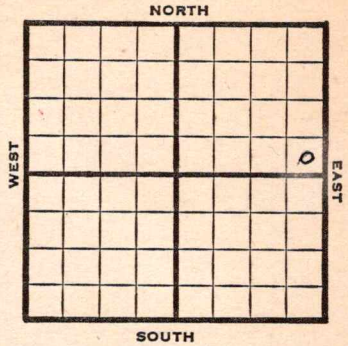

1948 **Elev. 1310'** REPORT

- 3/17 Location
- 3/24 Mach.
- 3/31 15" @ 60'
Drlg. 300'
- 4/7 12" @ 1730'
Drlg. 1470'
- 4/14 Drlg. 2280'
- 4/21 **KC 2100'**
8" @ 2282'
Bart 2700'
Chat 2720'
7" @ 2735'
Drlg. 2738'
- 4/28 5" @ 3107'
Viola 3110'?
TD 3118'
- 5/5 Drlg. 3220'
- 5/12 **Viola 3110'**
TD 3220'
Abd.

ABANDONED

Map No. _____ Sec. 34 Twp. 27 R. 5E

Well No. 1 Kreeger

H. & M. Drlg. Company

FIRST REPORT Contractor

SE NE

SECTION PLAT

_____ Ft. from N. Line

330 Ft. from S. Line

330 Ft. from E. Line

_____ Ft. from W. Line

Butler County

Location X

Rig up _____

Drilling and Remarks:

RECORD

Cased _____ in., _____ ft.

Sand _____

Gas _____

Oil _____

Total Depth _____

PRODUCTION

1st 24 hrs. Nat. _____

1st 24 hrs. after shot _____

Gas _____ Cu. Ft.

Dry Hole _____

Abandoned _____

Date

MAR 17 1948

19

S. J. LEWIS Scout

Map No. 11 Sec. 34 Twp. 27 R. 5E

Well No. 1 Kreegar

H. & M. Drlg. Company

ABANDONED

Contractor

SE NE

E1, B10
SECTION PLAT

 Ft. from N. Line

330 Ft. from S. Line

330 Ft. from E. Line

 Ft. from W. Line

			0

Butler County

Location

Rig up

Drilling and Remarks:

Wolca 3110

RECORD

Cased in., ft.

Sand

Gas

Oil

Total Depth 3220

PRODUCTION

1st 24 hrs. Nat.

1st 24 hrs. after shot

Gas Cu. Ft.

Dry Hole

Abandoned

Date

MAY 12 1948 19

S. J. LEWIS Scout