

Map No. _____ Sec. 22 Twp. 32 R 4

Well No. 3 - Hibbins Farm
T. B. Slick Company


_____ Ft. from N. Line

1095 Ft. from S. Line

_____ Ft. from E. Line

225 Ft. from W. Line

1927

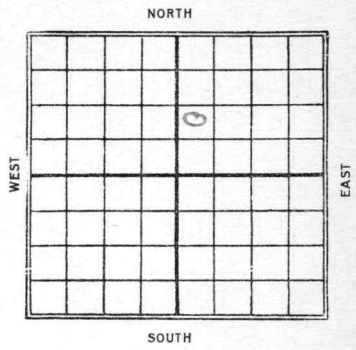

Date	REPORT
3/9	Drlg 1670
3/16	Top sand 2357-67 - Est. 100 bbls.
3/24	sand 2357-2367
	30/75 bbls
	T.D. 2367'
1928	O.W.D.D.
3/8	Rigging up
3/16	Rigging up - T.D. 2367-
3/22	Drlg 2440
3/29	" 2878
4/5	Sand 2912-52 - 4 MG gas
4/12	2912-52 T.D. 2952
	4 MG gas

Cowley

Map No. 2 KANSAS Sec. 22 Twp. 32 R. 4

Well No. 3 Dibbins

T. B. Slicks Company

Contractor

FIRST REPORTS

SECTION PLAT

----- Ft. from N. Line

1095 Ft. from S. Line

----- Ft. from E. Line

225 Ft. from W. Line

lot 2 - blocks 1

Reynolds Addition

		o	

Location -----

Rig up -----

Drilling and Remarks:

Dry 1670

RECORD

Cased ----- in., ----- ft.

Sand -----

Gas -----

Oil -----

Total Depth -----

PRODUCTION

1st 24 hrs. Nat. -----

1st 24 hrs. after shot -----

Gas ----- Cu. Ft.

Dry Hole -----

Abandoned -----

Date

MAR 9 1927

CHAS. L. SHERWOOD

192

Scout

Cawley

2 KANSAS Map No. Sec. 22 Twp. 32 R. 4

Well No. 3 Stephens

T. B. Shick Company

Contractor

COMPLETED

SECTION PLAT

Ft. from N. Line

1095 Ft. from S. Line

Ft. from E. Line

225 Ft. from W. Line

		o	

Location

Rig up

Drilling and Remarks:

307 75 lbs

RECORD

Cased in., ft.

Sand 2357-2367

Gas

Oil

Total Depth 2367

PRODUCTION

1st 24 hrs. Nat.

1st 24 hrs. after shot

Gas Cu. Ft.

Dry Hole

Abandoned

Date

MAR 24 1927

CHAS. L. SHERWOOD

192

Scout

Cowley

Map No. 2 KANSAS Sec. 22 Twp. 32 R. 4

Well No. 3 *Dobbins*

T. B. Slick

Company

Contractor

FIRST REPORTS

SECTION PLAT

----- Ft. from N. Line

1095 Ft. from S. Line

----- Ft. from E. Line

225 Ft. from W. Line

		o	

hot 2 bls, Reynolds (new)

Location " *QWD* "

Rig up

Drilling and Remarks:

old 20 2367'
Rigging up to
well deeper.

RECORD

Cased ----- in., ----- ft.

Sand -----

Gas -----

Oil -----

Total Depth -----

PRODUCTION

1st 24 hrs. Nat. -----

1st 24 hrs. after shot -----

Gas ----- Cu. Ft.

Dry Hole -----

Abandoned -----

Date

MAR 8 1928

CHAS. L. SHERWOOD

1928 Scout

2 KANSAS

Cowley

Map No. _____ Sec. 22 Twp. 32 R. 4

Well No. 3 Dibbins

T. B. Dick

Company

Contractor

COMPLETED

SECTION PLAT

_____ Ft. from N. Line

1095 _____ Ft. from S. Line

_____ Ft. from E. Line

225 _____ Ft. from W. Line

		o	

Lot r. Bly, Reynolds

Location _____

Rig up _____

Drilling and Remarks:

good well

RECORD

Cased _____ in., _____ ft.

Sand 2912-52

Gas _____

Oil _____

Total Depth 2952

PRODUCTION

1st 24 hrs. Nat. _____

1st 24 hrs. after shot _____

Gas 4 49 Cu. Ft.

Dry Hole _____

Abandoned _____

Date

APR 12 1928

CHAS. L. SHERWOOD

192

Scout