


Cowley

Map No. _____ Sec. *22* Twp. *32* R. *4*

Well No. *5 - Dibbins* Farm
T.B. Slick Company

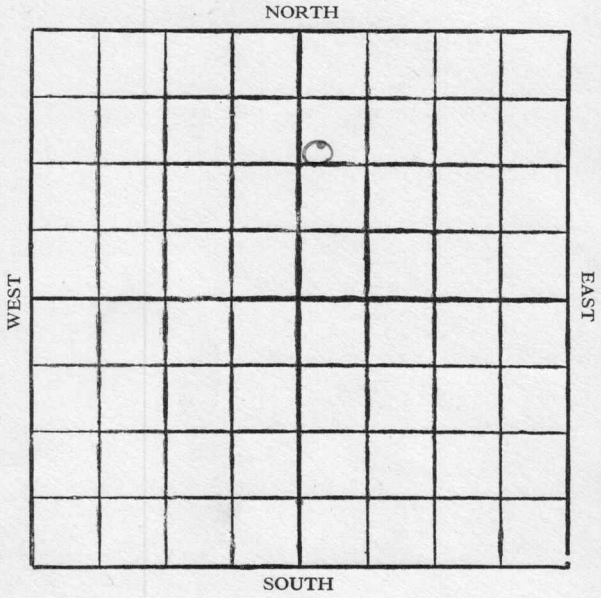

Location

Drilling Remarks

.....

.....

RECORD

Cased..... in. ft.

Sand

Gas

Oil

Total Depth.....

Rig Up.....

Drilling Remarks

.....

.....

PRODUCTION

1st 24 hrs. Nat.....

1st 24 hrs. after shot.....

Gas..... cu. ft.

Dry Hole.....

Abandoned.....

Cowley

Map No. _____ Sec. 22 Twp. 32 R 4

Well No. 5 - Sibbina Farm

F. B. Slick Company


1170 Ft. from N. Line

_____ Ft. from S. Line

_____ Ft. from E. Line

150 Ft. from W. Line

1921

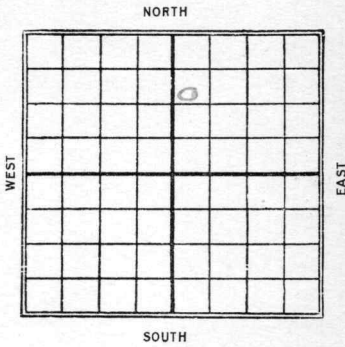

Date	REPORT
------	--------

4/13	Location
------	----------

4/20	_____
------	-------

4/27	Bldg rig
------	----------

5/5	Rig
-----	-----

5/12	_____
------	-------

5/18	Drlg 275
------	----------

5/25	" 500
------	-------

6/1	" 1625
-----	--------

6/7	" 1930
-----	--------

6/15	Sand 2301 - 2371 - Est 30 bbls. natural - Will shoot -
------	---

6/22	Sand 2301 - 2379 40 / 4358 - 79 25 bbls
------	---

	T.O. 2379
--	-----------

Cowley

Map No. 2 KANSAS Sec. 22 Twp. 32 R. 4

Well No. 5 Dickins

T. B. Shick

Company

Contractor

FIRST REPORTS

SECTION PLAT

1170 Ft. from N. Line

----- Ft. from S. Line

----- Ft. from E. Line

150 Ft. from W. Line

Location

Rig up -----

Drilling and Remarks:

RECORD

Cased ----- in., ----- ft.

Sand -----

Gas -----

Oil -----

Total Depth -----

PRODUCTION

1st 24 hrs. Nat. -----

1st 24 hrs. after shot -----

Gas ----- Cu. Ft.

Dry Hole -----

Abandoned -----

Date

APR 13 1927

CHAS. L. SHERWOOD

192

Scout

2 KANSAS Cowley
Map No. _____ Sec. 22 Twp. 32 R. 4

Well No. 5 Diggins
T. B. Slick _____ Company

_____ Contractor

COMPLETED

SECTION PLAT

1170 Ft. from N. Line

_____ Ft. from S. Line

_____ Ft. from E. Line

150 Ft. from W. Line

Location _____

Rig up _____

Drilling and Remarks:

407 2388-79

25 lbs.

RECORD

Cased _____ in., _____ ft.

Sand 2301-2379

Gas _____

Oil _____

Total Depth 2379

PRODUCTION

1st 24 hrs. Nat. _____

1st 24 hrs. after shot _____

Gas _____ Cu. Ft.

Dry Hole _____

Abandoned _____

Date

JUN 22 1927