


Section 22 Township 32 Range 4 E

Well No. # 6 Dibbons

Company K. T. Weideman

NORTH

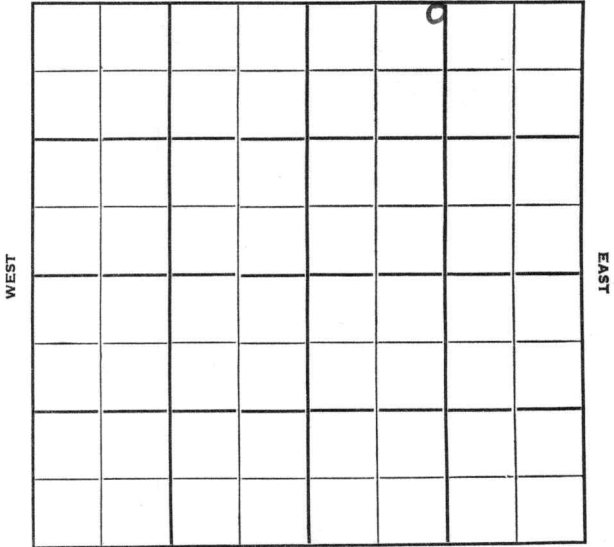

SOUTH

Sec. 22 Twp. 32 R. 4 E

Well No. # 6 Dibbons Farm

K. T. Weideman Company

Contractor


70 State
Ft. from N. Line

Ft. from S. Line

Ft. from E. Line

1200 Ft. from W. Line

NE NE NW NE

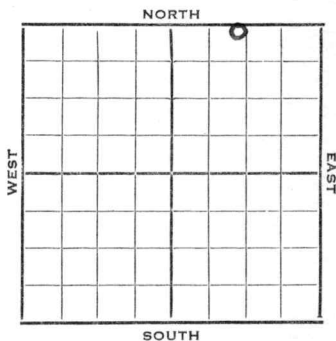

1952 Elev. 1218' REPORT

9/17 Spud 9-9-52
10" @ 80
Drlg. 1725'

10/22 Spud 9-9-52
D & A TD 2407' 10" @ 80
Layton 2316' TD 2384' 7" @ 2384
DD 2407' D & A

ABANDONED

County **Cowley** State **Kansas**

Sec. **22** (Blk. (Twp.)) **32** (Sur. (Rge.)) **4E** Map No.

Operator **K. T. Weideman**

Well No. **6** Farm **Dibbons**

Elev. Location **NE NE NW NE**

70 Ft. From **N** Line **NE**
1200 Ft. From **W** Line Quarter

1st. Report **SEP 17 1952**

Completion

Remarks

Spudding Date **9-9-52**

Drlg. Data State

10" @ 80 Drlg. 1725

J. G. McGEHEE

County Cowley State Kansas

Sec. 22 (Blk. 6 Twp.) 32 (Sur. 4E Rge.) 4E Map No.

Operator K. T. Weidemann

Well No. 6 Farm Dibbons

Elev. 1218 Location NE NE NW NE

70 Ft. From N Line NE

1200 Ft. From W Line Quarter

1st. Report

Completion OCT 22 1952

Remarks

Spudding Date 9-9-52

Drig. Data D & A TD 2407

10" @ 80 Layton 2316 TD 2384

7" @ 2384 DD 2407

D & A