


KANSAS

Butler

Section 3 Township 27 Range 6E

Well No. 1 Fee

Company Kimmel et al

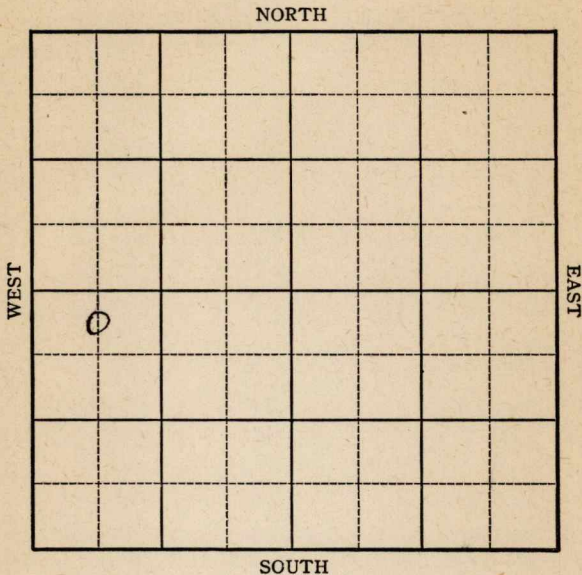

Butler County

KANSAS
6E

Sec. 3 Twp. 27 R. 6E

Well No. #1 Fee Farm

Kimmel et al Company


Miscellaneous

330 Ft. from N. Line

 Ft. from S. Line

 Ft. from E. Line

660 Ft. from W. Line

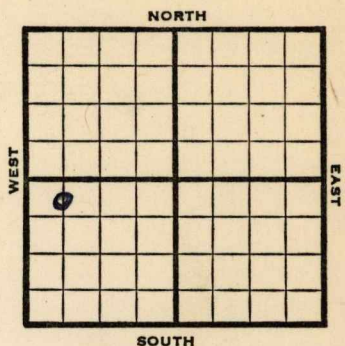

CNL NW SW

1946	Elev. 1415 REPORT
5/29	260 Run 15" Lewis Lease All wells plugged
6/5	Drlg. 950'
6/12	Miss 2743 6" @ 2743 Drlg 2909'
6/18	KC 2120 Drlg 2243'
6/26	" "
7/3	TD 2850'
7/9	90 qts Co
7/16	"
7/23	"
7/30	"
8/6	"
8/13	"
8/21	KC 2120 10" @ 1878 Miss. 2761 TD 2850' Pump 3 Pot. Grav. 38.0

COMPLETED

KANSASKansas Pool Name MiscellaneousMap No. 11 Sec. 3 Twp. 27 R. 6EWell No. 1 FeeKimmel et al

Company

FIRST REPORT

Contractor

C N L NW SW

SECTION PLAT330 Ft. from N. Line Ft. from S. Line Ft. from E. Line660 Ft. from W. Line

0			

Butler CountyLocation Rig up

Drilling and Remarks:

260 Run 15"Lewis LeaseAll wells plugged**RECORD**Cased in., ft.Sand Gas Oil Total Depth **PRODUCTION**1st 24 hrs. Nat. 1st 24 hrs. after shot Gas Cu. Ft.Dry Hole Abandoned

Date

MAY 29 1946

19


S. J. LEWIS

Scout

Pool Name Miscellaneous**KANSAS** KansasMap No. 11 Sec. 3 Twp. 27 R. 6EWell No. 1 Fee _____Kimmel et al. Company**COMPLETED**

Contractor

C N L NW SW

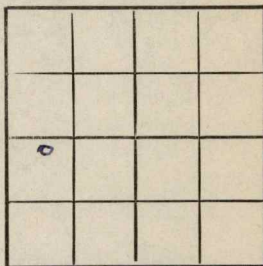E1, 1415
SECTION PLAT330 Ft. from N. Line

_____ Ft. from S. Line

_____ Ft. from E. Line

660 Ft. from W. LineButler County

Location _____

Rig up _____

Drilling and Remarks:

KC212010" @ 1878M1252961Pump 3 Pst380-44**RECORD**

Cased _____ in., _____ ft.

Sand _____

Gas _____

Oil _____

Total Depth 2850**PRODUCTION**

1st 24 hrs. Nat. _____

1st 24 hrs. after shot _____

Gas _____ Cu. Ft.

Dry Hole _____

Abandoned _____

Date

AUG 21 1946

19

S. J. LEWIS

Scout