


Section 3 Township 27 Range 6E

Well No. 1 Kimball

Company H. & N Drlg et al

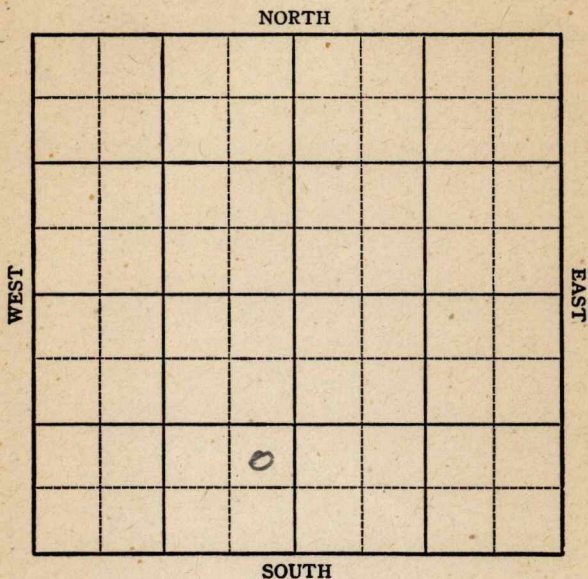

KANSAS

Butler county ✓

Sec. 3 Twp. 27 R. 6E

Well No. 1 Kimball Farm

H & N Drlg. et al Company

Miscellaneous

_____ Ft. from N. Line


990

_____ Ft. from S. Line

330

_____ Ft. from E. Line

_____ Ft. from W. Line

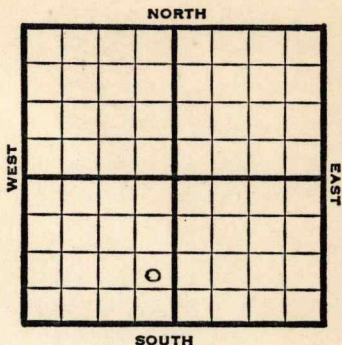

NE SE SW

1947

Elev. 1385' REPORT

5/28 Location

6/3 Mach

6/10 "

6/17 Spud.

6/24 12" @ 715'
Drlg. 1055'

7/1 Drlg 1860'
10" @ 1049'

7/8 Drlg. 1950'

7/16 8" @ 1949'
Kansas City 2190-2200'

7/22 "

7/29 6" @ 2730'
Miss. 2730'
Drlg 3104'

8/6 **Viola 3125'**
TD 3150'
PB 2200'
5" @ 2190'

OVER

1947

8/13 Viola 3125'
5" @ 2190'
Kansas City 2190'
2000 Acid.
Pump 40 Pot.
Gr. 38
T.D. 3150'
Complete

COMPLETED

Map No. _____ Sec. 3 Twp. 27 R. 6E

Well No. 1 Kimball

H & N Drlg. etal. Company
FIRST REPORT

Contractor

NE SE SW

SECTION PLAT

		o	

_____ Ft. from N. Line

990 Ft. from S. Line

330 Ft. from E. Line

_____ Ft. from W. Line

Butler County

Location X

Rig up _____

Drilling and Remarks:

RECORD

Cased _____ in., _____ ft.

Sand _____

Gas _____

Oil _____

Total Depth _____

PRODUCTION

1st 24 hrs. Nat. _____

1st 24 hrs. after shot _____

Gas _____ Cu. Ft.

Dry Hole _____

Abandoned _____

Date

MAY 28 1947

19

S. J. LEWIS

Scout

