

KANSAS


Butler

Section 3 Township 27 Range 6-E

Well No. #1 Kimbal

Company Ritchie et al

NORTH (Reynolds & Schaff-
er)

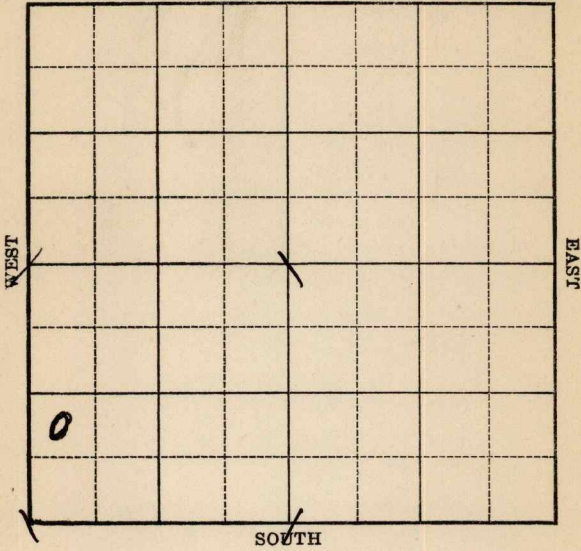

KANSAS

Butler


Sec. 3 Twp. 27 R. 6-EWell No. #1 Kimbal (Twin to Abd. well) Farm

Ritchie et al

Company

(Reynolds & Schaffer)

NORTH

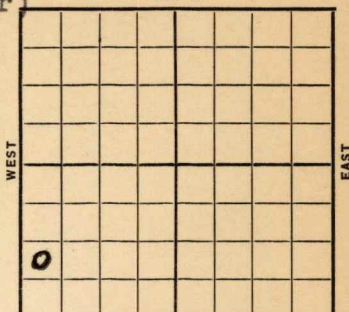

WEST

EAST

SOUTH

 Ft. from N. Line990

Ft. from S. Line

 Ft. from E. Line300

Ft. from W. Line

Date

REPORT

1939

2/8

10" - 700'.

8" - 1200'.

6" - 1875'.

5" - 2282'.

Sand 2409-19' SO

T. D. 2475'.

FIRST REPORT

and
ABANDONED

KANSAS

Butler

Map No. 11 Sec. 3 Twp. 27 R. 6EWell No. 1 Kimbal (*Twin To abandoned hole*)

Ritchie et al

Company

FIRST REPORT

Contractor

COMPLETED

APPROX.

NW SW SW

Ft. from N. Line

990 Ft. from S. Line

Ft. from E. Line

390 Ft. from W. Line

REYNOLDS AND
SCHAFFER POOL

SECTION PLAT

All other wells on This 1/4 have been abd.			
0			

Location _____

Rig up _____

Drilling and Remarks:

10" - 700

8 - 1200

6 - 1875

5 - 2282

Sand 2409-19 SO
TD 2475

D & A

RECORD

Cased _____ in., _____ ft.

Sand _____

Gas _____

Oil _____

Total Depth _____

PRODUCTION

1st 24 hrs. Nat. _____

1st 24 hrs. after shot _____

Gas _____ Cu. Ft.

Dry Hole _____

Abandoned _____

Date

FEB 8 - 1939

19

H. D. Hatfield Scout